
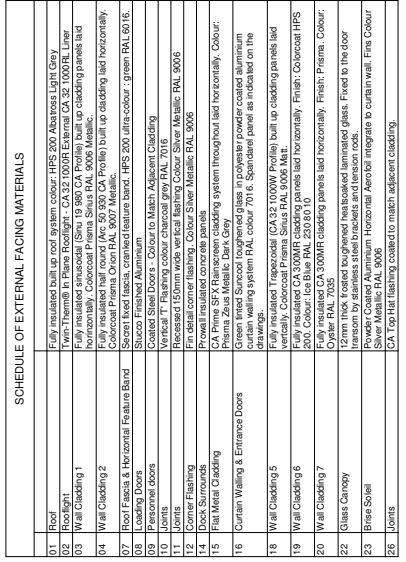
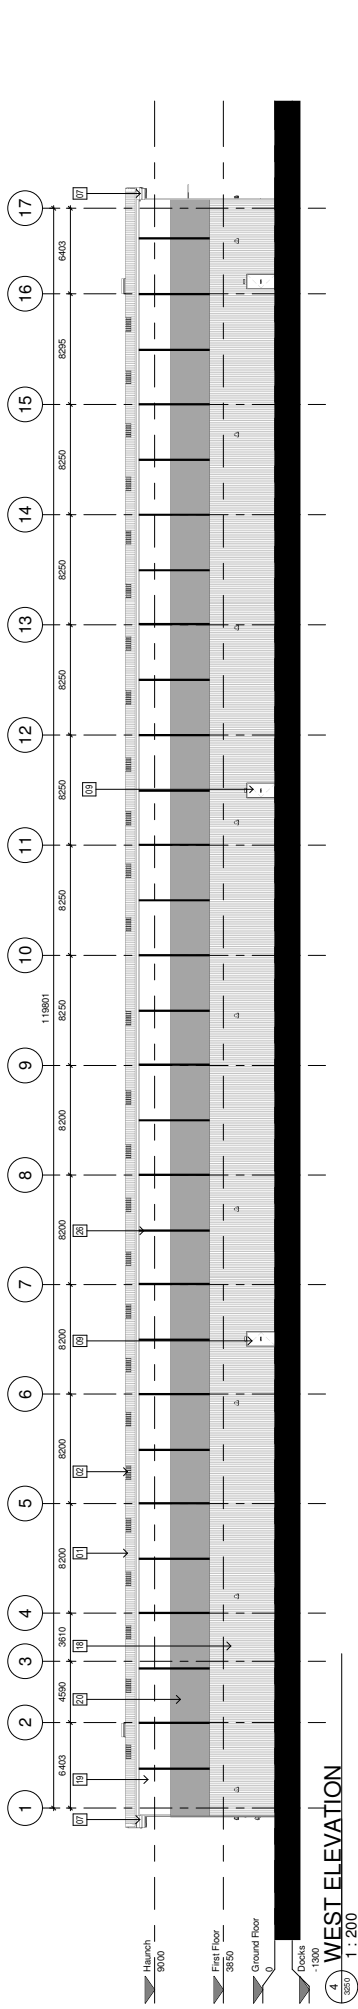
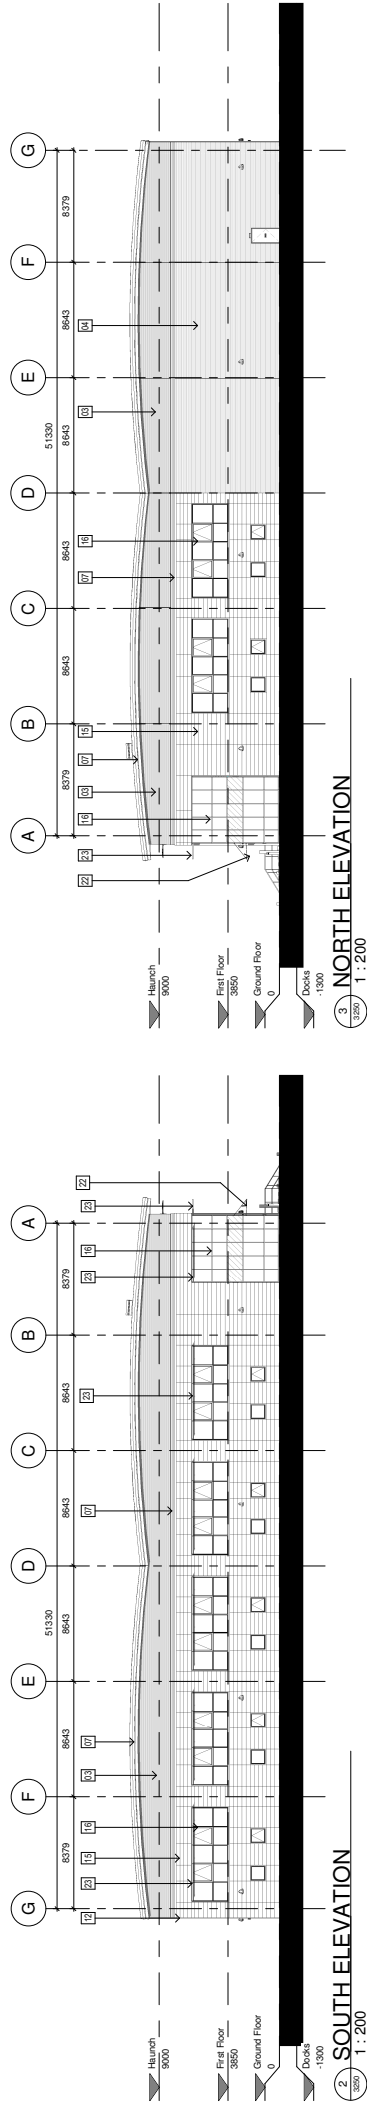


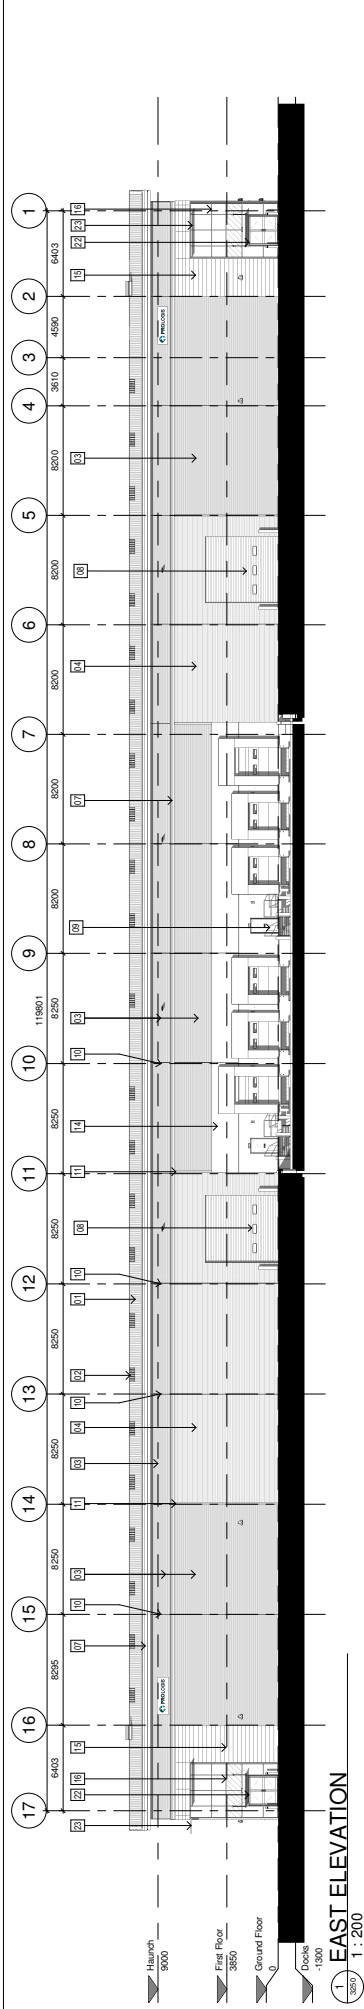

| SCHEDULE OF EXTERNAL FACING MATERIALS |                                        |                                                                                                                                                     |
|---------------------------------------|----------------------------------------|-----------------------------------------------------------------------------------------------------------------------------------------------------|
| 01                                    | Roof                                   | Fully insulated built up roof system colour: HPS 200 Alabastro Light Grey                                                                           |
| 02                                    | Rooflight                              | Twinn Thermix in Plane Rooflight - CA321 1000R External CA2 1000R/L User                                                                            |
| 03                                    | Wall Cladding 1                        | Horizontal, Coated Prima Sius RAL 9006 Metallic                                                                                                     |
| 04                                    | Wall Cladding 2                        | Fully insulated half round (Arc 90/90 CA Profile) built up cladding laid horizontally. Colocort Prima Orion RAL 9007 Metallic                       |
| 05                                    | Roof Finials & Horizontal Failure Band | Shurco Finial System Feature band HPS 200 Jetts colour - green RAL 6016                                                                             |
| 06                                    | Leading Down                           | Coated Steel Down - Colour to Match Adjacent Wall                                                                                                   |
| 07                                    | Personnel doors                        | Vertical 11' Flaming colour charcoal grey RAL 7016                                                                                                  |
| 10                                    | Joints                                 | Recessed 150mm wide vertical flashing Colour Silver Metallic RAL 9006                                                                               |
| 11                                    | Joists                                 | Pin detail corner flashing, Colour Silver Metallic RAL 9006                                                                                         |
| 12                                    | Corner Flashing                        | Pin detail corner flashing, Colour Silver Metallic RAL 9006                                                                                         |
| 13                                    | Door Flashing                          | CA Prima SPX Intercom cladding system throughout laid horizontally. Colour: Prima Jetts Metallic Dark Grey                                          |
| 14                                    | Wall Metal Cladding                    | Green tinted Suncoast textured glass in polycarbonate powder coated aluminium cladding system RAL 7016. Spandrel panel as indicated on the drawings |
| 15                                    | Curtain Walling & Entrance Doors       | Fully insulated Tripartecol (CA 321 1000W Profile) built up cladding panels laid vertically. Colocort Prima Sius RAL 9006 Metallic                  |
| 18                                    | Wall Cladding 5                        | Horizontal, Coated Prima Sius RAL 9006 Metallic                                                                                                     |
| 19                                    | Wall Cladding 6                        | 200. Colour Blue RAL 2010 90 10                                                                                                                     |
| 20                                    | Wall Cladding 7                        | 200. Colour Blue RAL 2010 90 10                                                                                                                     |
| 21                                    | Wall Cladding 8                        | Fully insulated CA 300MR cladding panels laid horizontally. Finish: Prima. Colour: Oyster RAL 7035                                                  |
| 22                                    | Glass Overlay                          | Pin detail corner flashing, Green tinted textured laminated glass. Fixed to the door transition by stainless steel brackets and tension rods.       |
| 23                                    | Brass Soffit                           | Powder Coated Aluminium Horizontal Anodol integrate to curtain wall. Finish: Colour Silver Metallic RAL 9006                                        |
| 26                                    | Joints                                 | CA Top hat flashing coated to match adjacent cladding.                                                                                              |

THIS "AS-BUILT" DRAWING IS BASED ON INFORMATION SUPPLIED TO MICHAEL SPARKS ASSOCIATES BY WINVIC AND INCORPORATES INSTRUCTIONS AND OTHER DESIGN INFORMATION GIVEN WINVIC DIRECTLY BY OTHERS

# AS BUILT

[illegible][illegible][illegible]

This drawing contains the following model files:

|                             |                              |
|-----------------------------|------------------------------|
| Steel Structure             | MAYGT-SDBL-DC23-XX-M3-S-1450 |
| Cracking                    | MAYGT-Y5IS-DC23-XX-M3-S-1830 |
| Curtain walling and windows | MAYGT-SPD-DC23-XX-M3-S-9002  |
| Mechanical                  | MAYGT-JEG-DC23-ZZ-M3-M-1001  |
| Electrical                  | MAYGT-JEG-DC23-ZZ-M3-E-1001  |