




REVISIONS					
REV	DESCRIPTION	DRAWN	CHKD	DATE	
1st	First Issue	JN	JN	03 08 21	

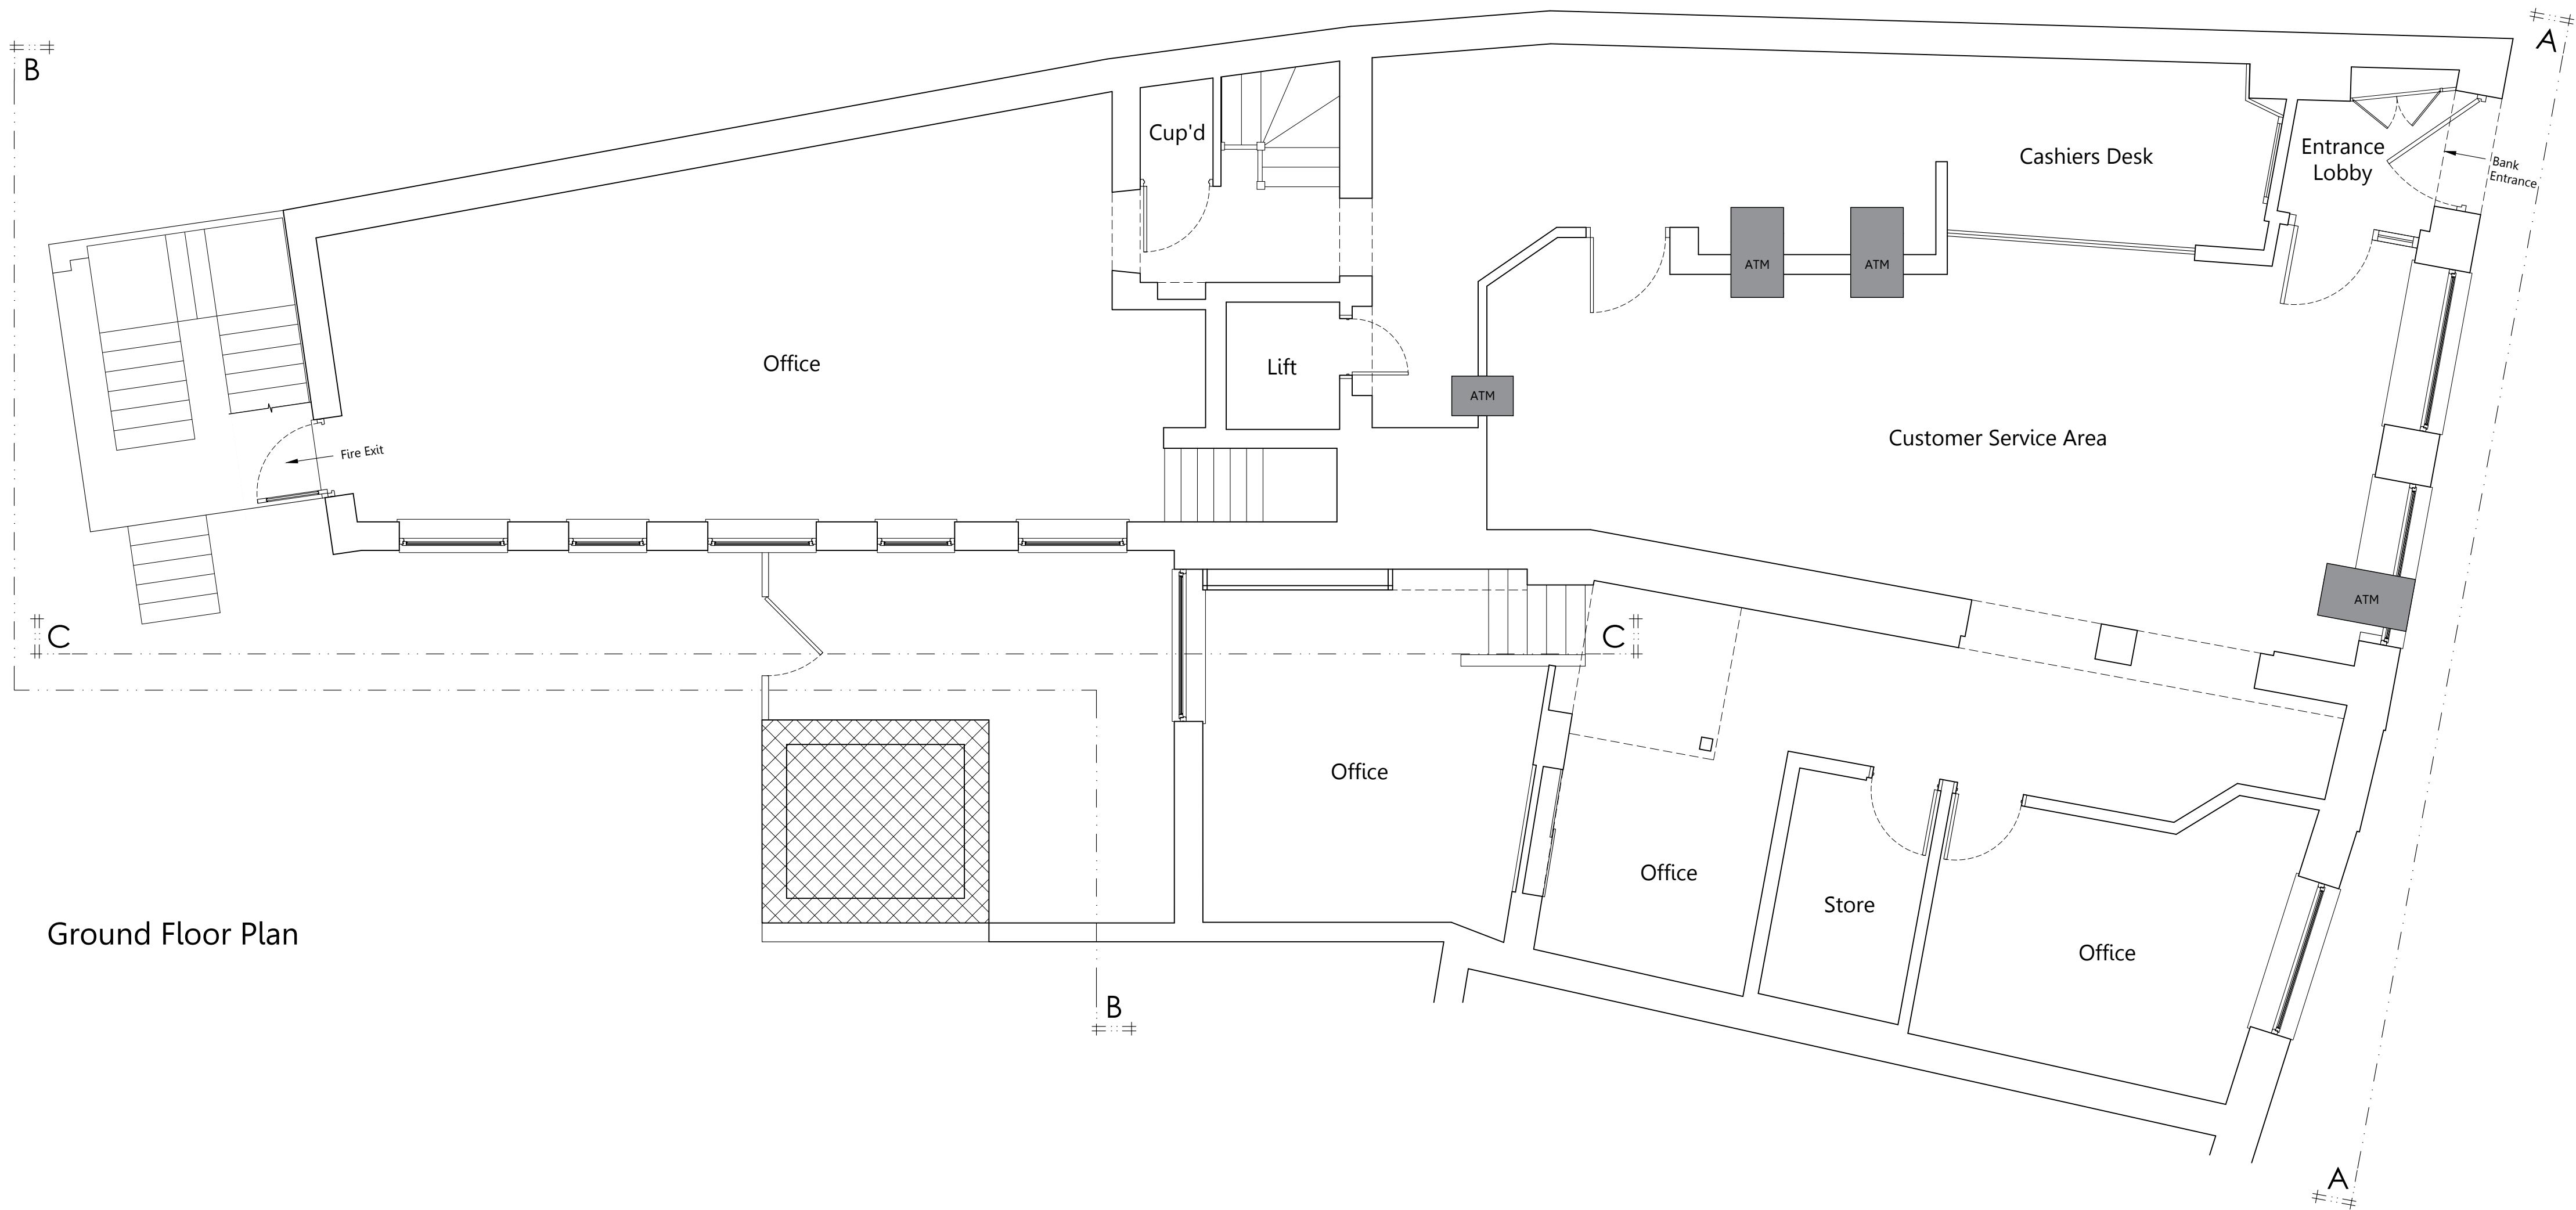

Ground Floor Plan

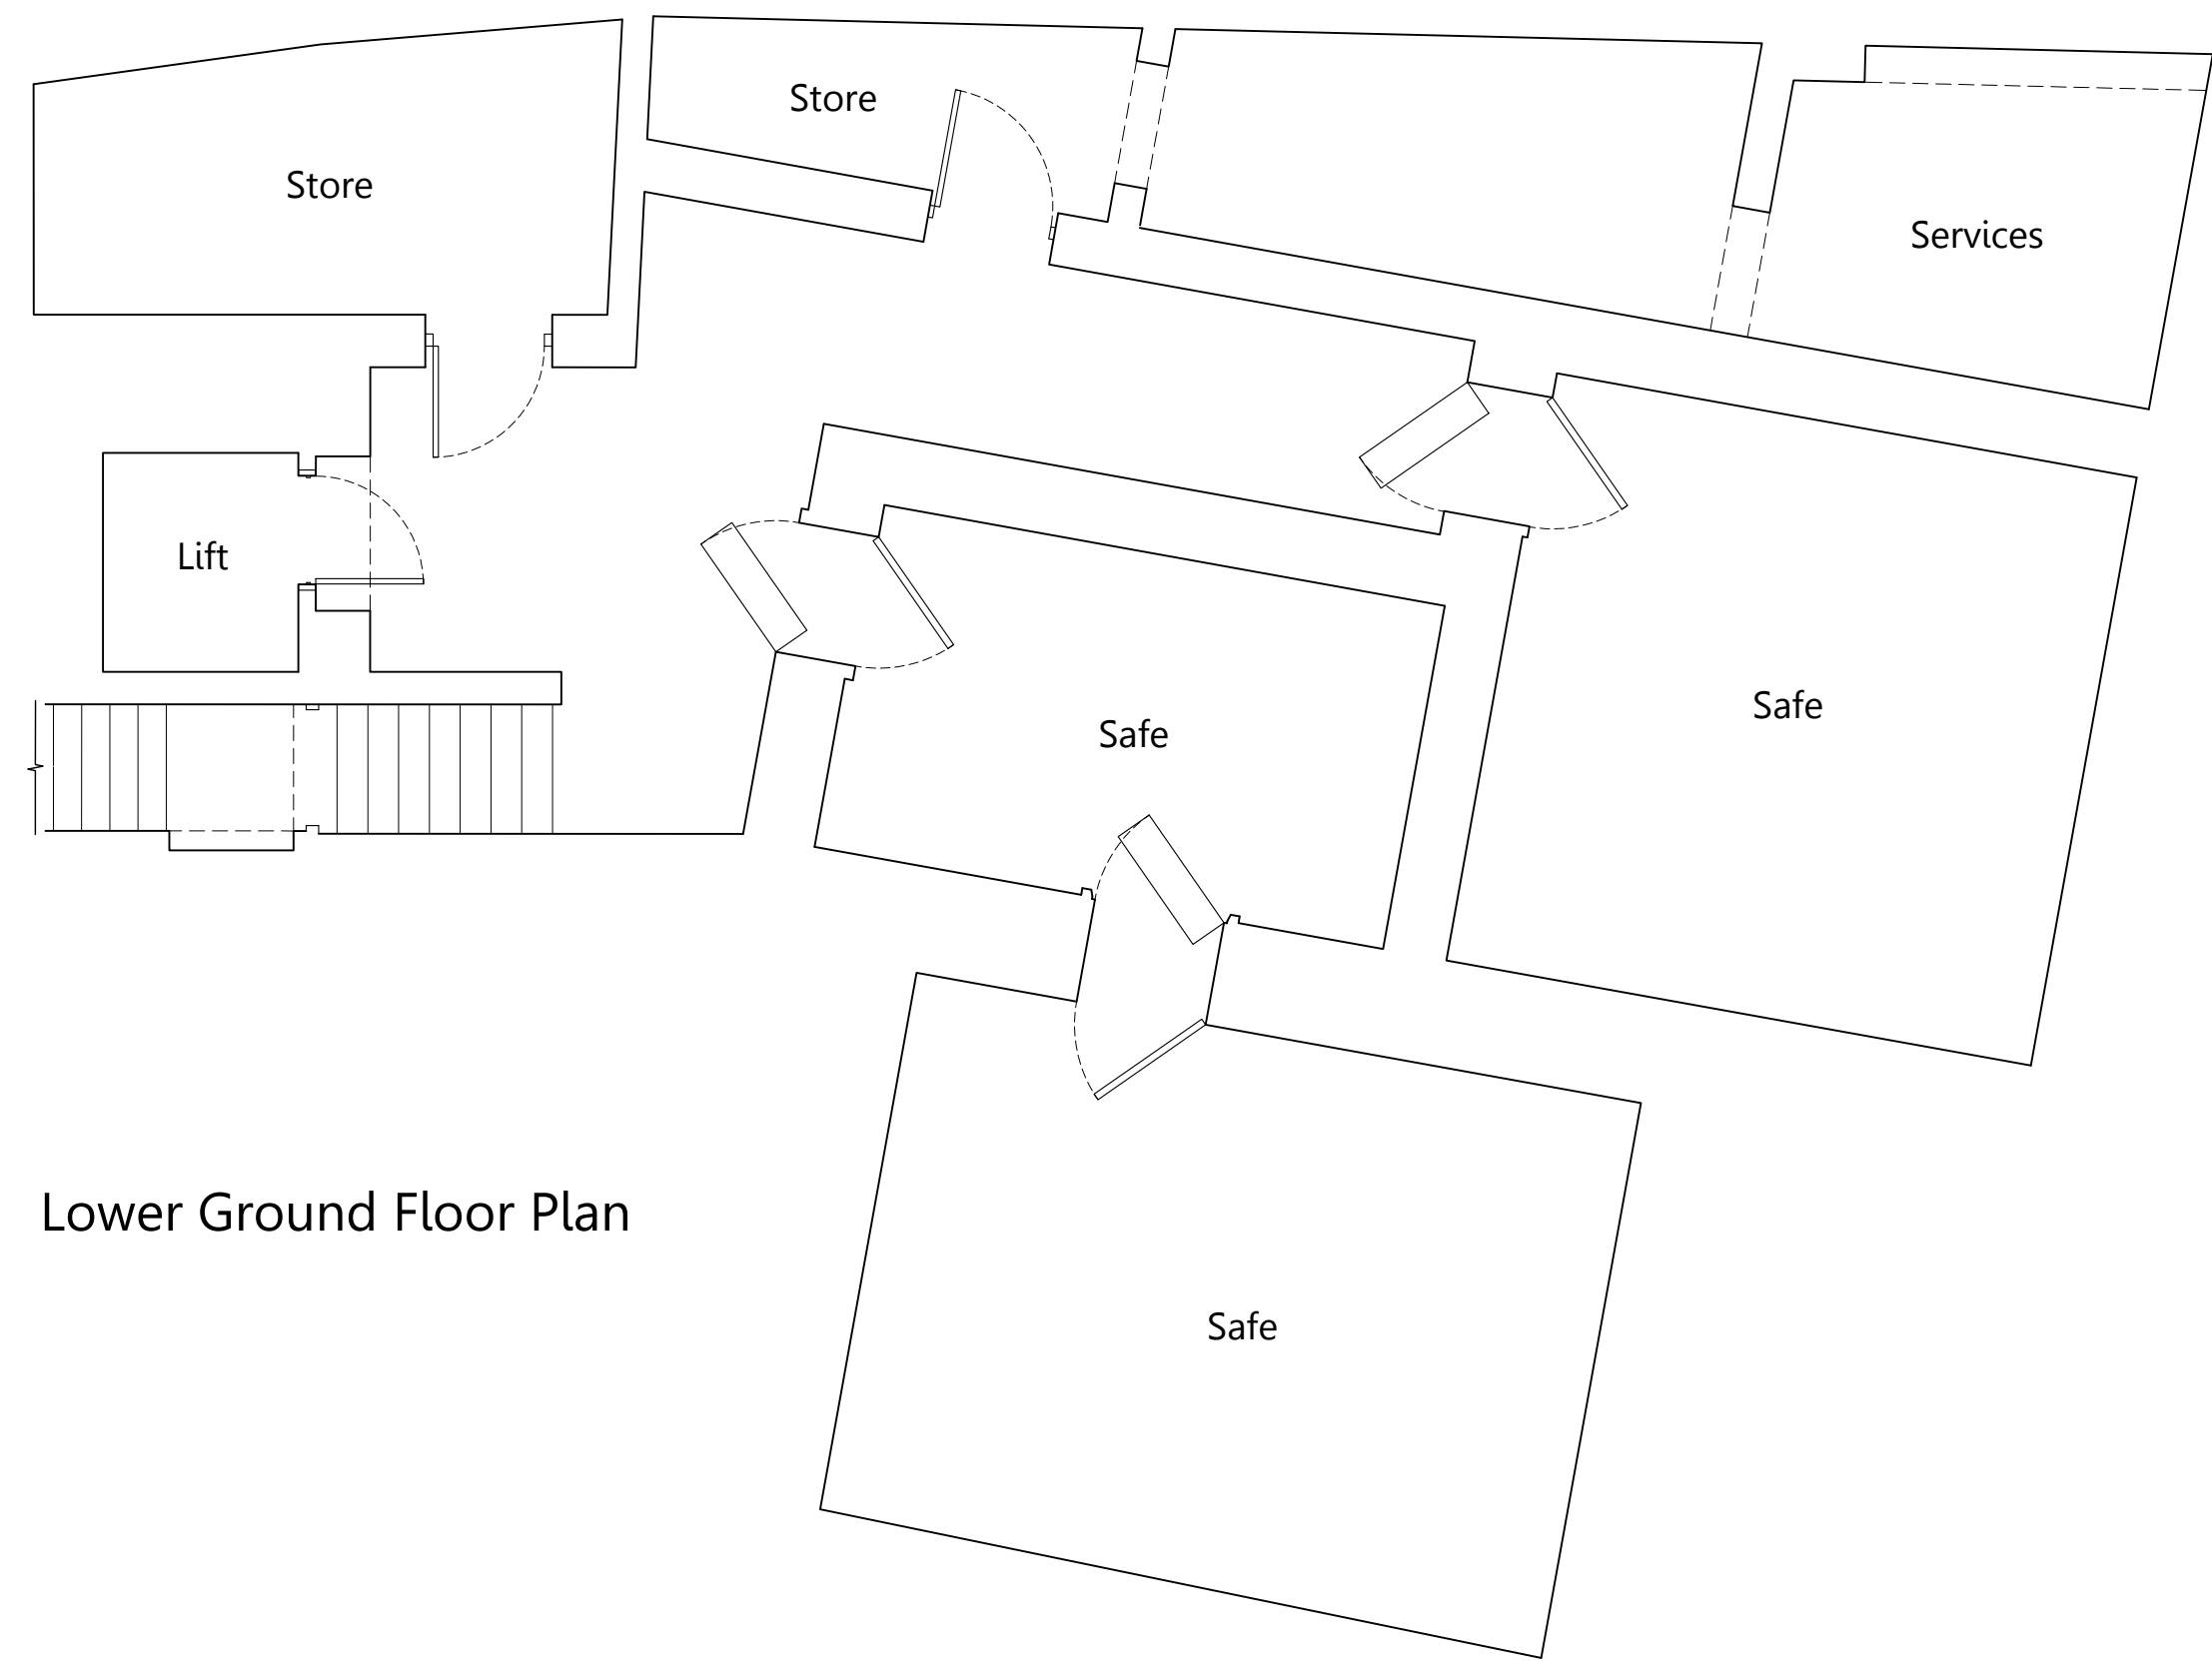

Lower Ground Floor Plan

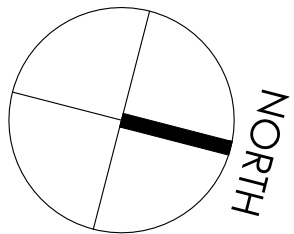

- NOTES
1. DRAWING TO BE READ IN CONJUNCTION WITH SPECIFICATION AND ALL RELEVANT DRAWINGS.
 2. DO NOT SCALE FROM THIS DRAWING UNLESS FOR PLANNING OR TRANSFER PURPOSES - FIGURED DIMENSIONS SHOULD BE USED WHERE SHOWN.
 3. IF YOU ARE IN DOUBT OF THE CONTENTS OF THE DRAWING, PLEASE REPORT DISCREPANCIES TO THE ARCHITECT.
 4. THE ARCHITECT IS NOT LIABLE FOR ANY FAULTS RELIED ON BY THIRD PARTY CONSULTANTS

PROJECT					
Barclays					
The Broadway, Stanmore					
DRAWING TITLE					
Floor Plans (1 of 2)					
SHEET NO.					
CP/2021/50/10 - 1st					
SCALE	SHEET SIZE	DATE	CLIENT	PURPOSE	
1:50/100	A1/A3	03 08 21	R. Lakhani	AS BUILT	