


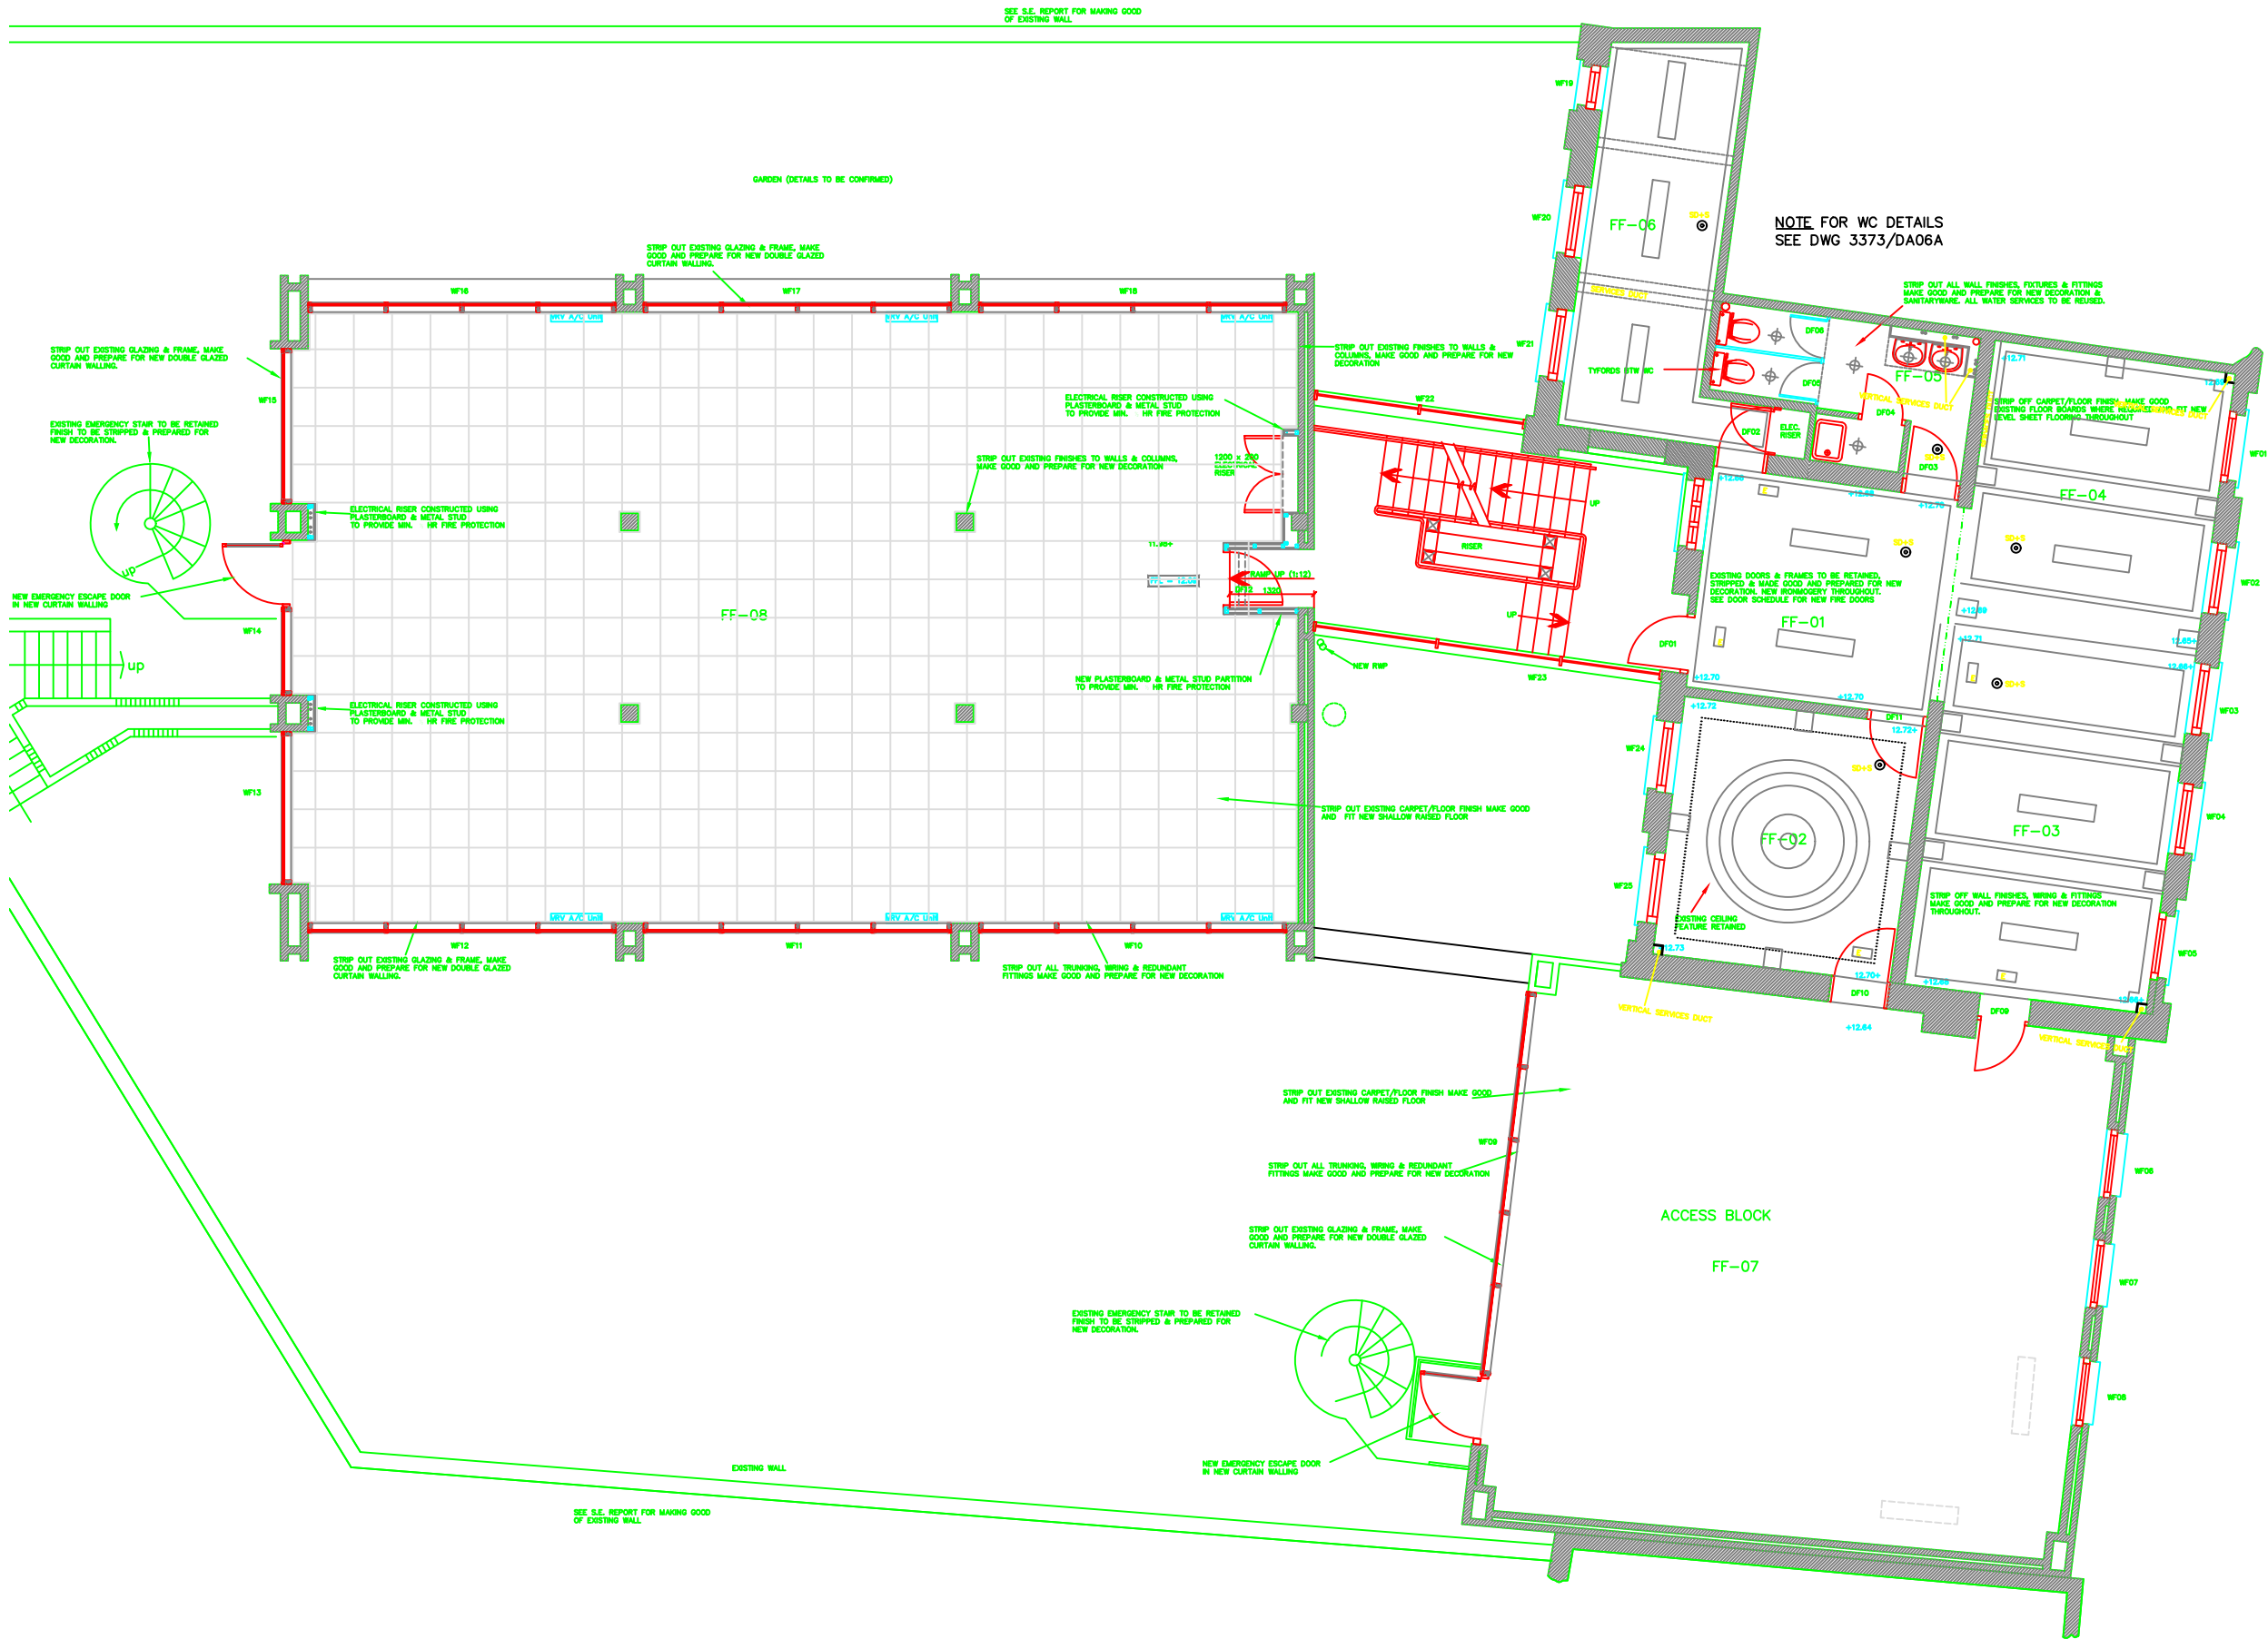

REV B	AS BUILT DRAWING	27/08/01
REV A	GENERAL UPDATE	20/02/01
CODE	DESCRIPTION	INITIAL
REVISIONS		

MCKAY SECURITIES PLC

CLIENT

REFURBISHMENT OF
ALBION HOUSE
OXFORD ROAD, NEWBURY

PROJECT

FIRST FLOOR PLAN
AS PROPOSED

DRAWING	
PROJECT NUMBER	3373
DRAWING NUMBER	GA21 B
SCALE	1:50
DATE	MAR 01
DRAWN	SD
CHECKED	

NEWBURY	The Long Barn - Welford - Newbury - RG20 8WZ
	Telephone (01488) 457937 Fax (01488) 457937 email@begin-architects.demon.co.uk
LONDON	25 Manchester Square - London - W1M 5AP
	Telephone (020) 7486 9486 Fax (020) 7486 8487 email@begin-architects.demon.co.uk
BATH	28 Welford Street - Bath BA1 2BT
	Telephone (01225) 483277 Fax (01225) 483277 email@begin-architects.demon.co.uk

© O. ARCHITECTURAL PARTNERSHIP'S PLC 1990
Check all dimensions and report any errors or omissions. Do not scale this drawing

**SUTTON GRIFFIN
& MORGAN**

Chartered Architects
Project Managers - Planners - Interior Designers - Landscape Designers