


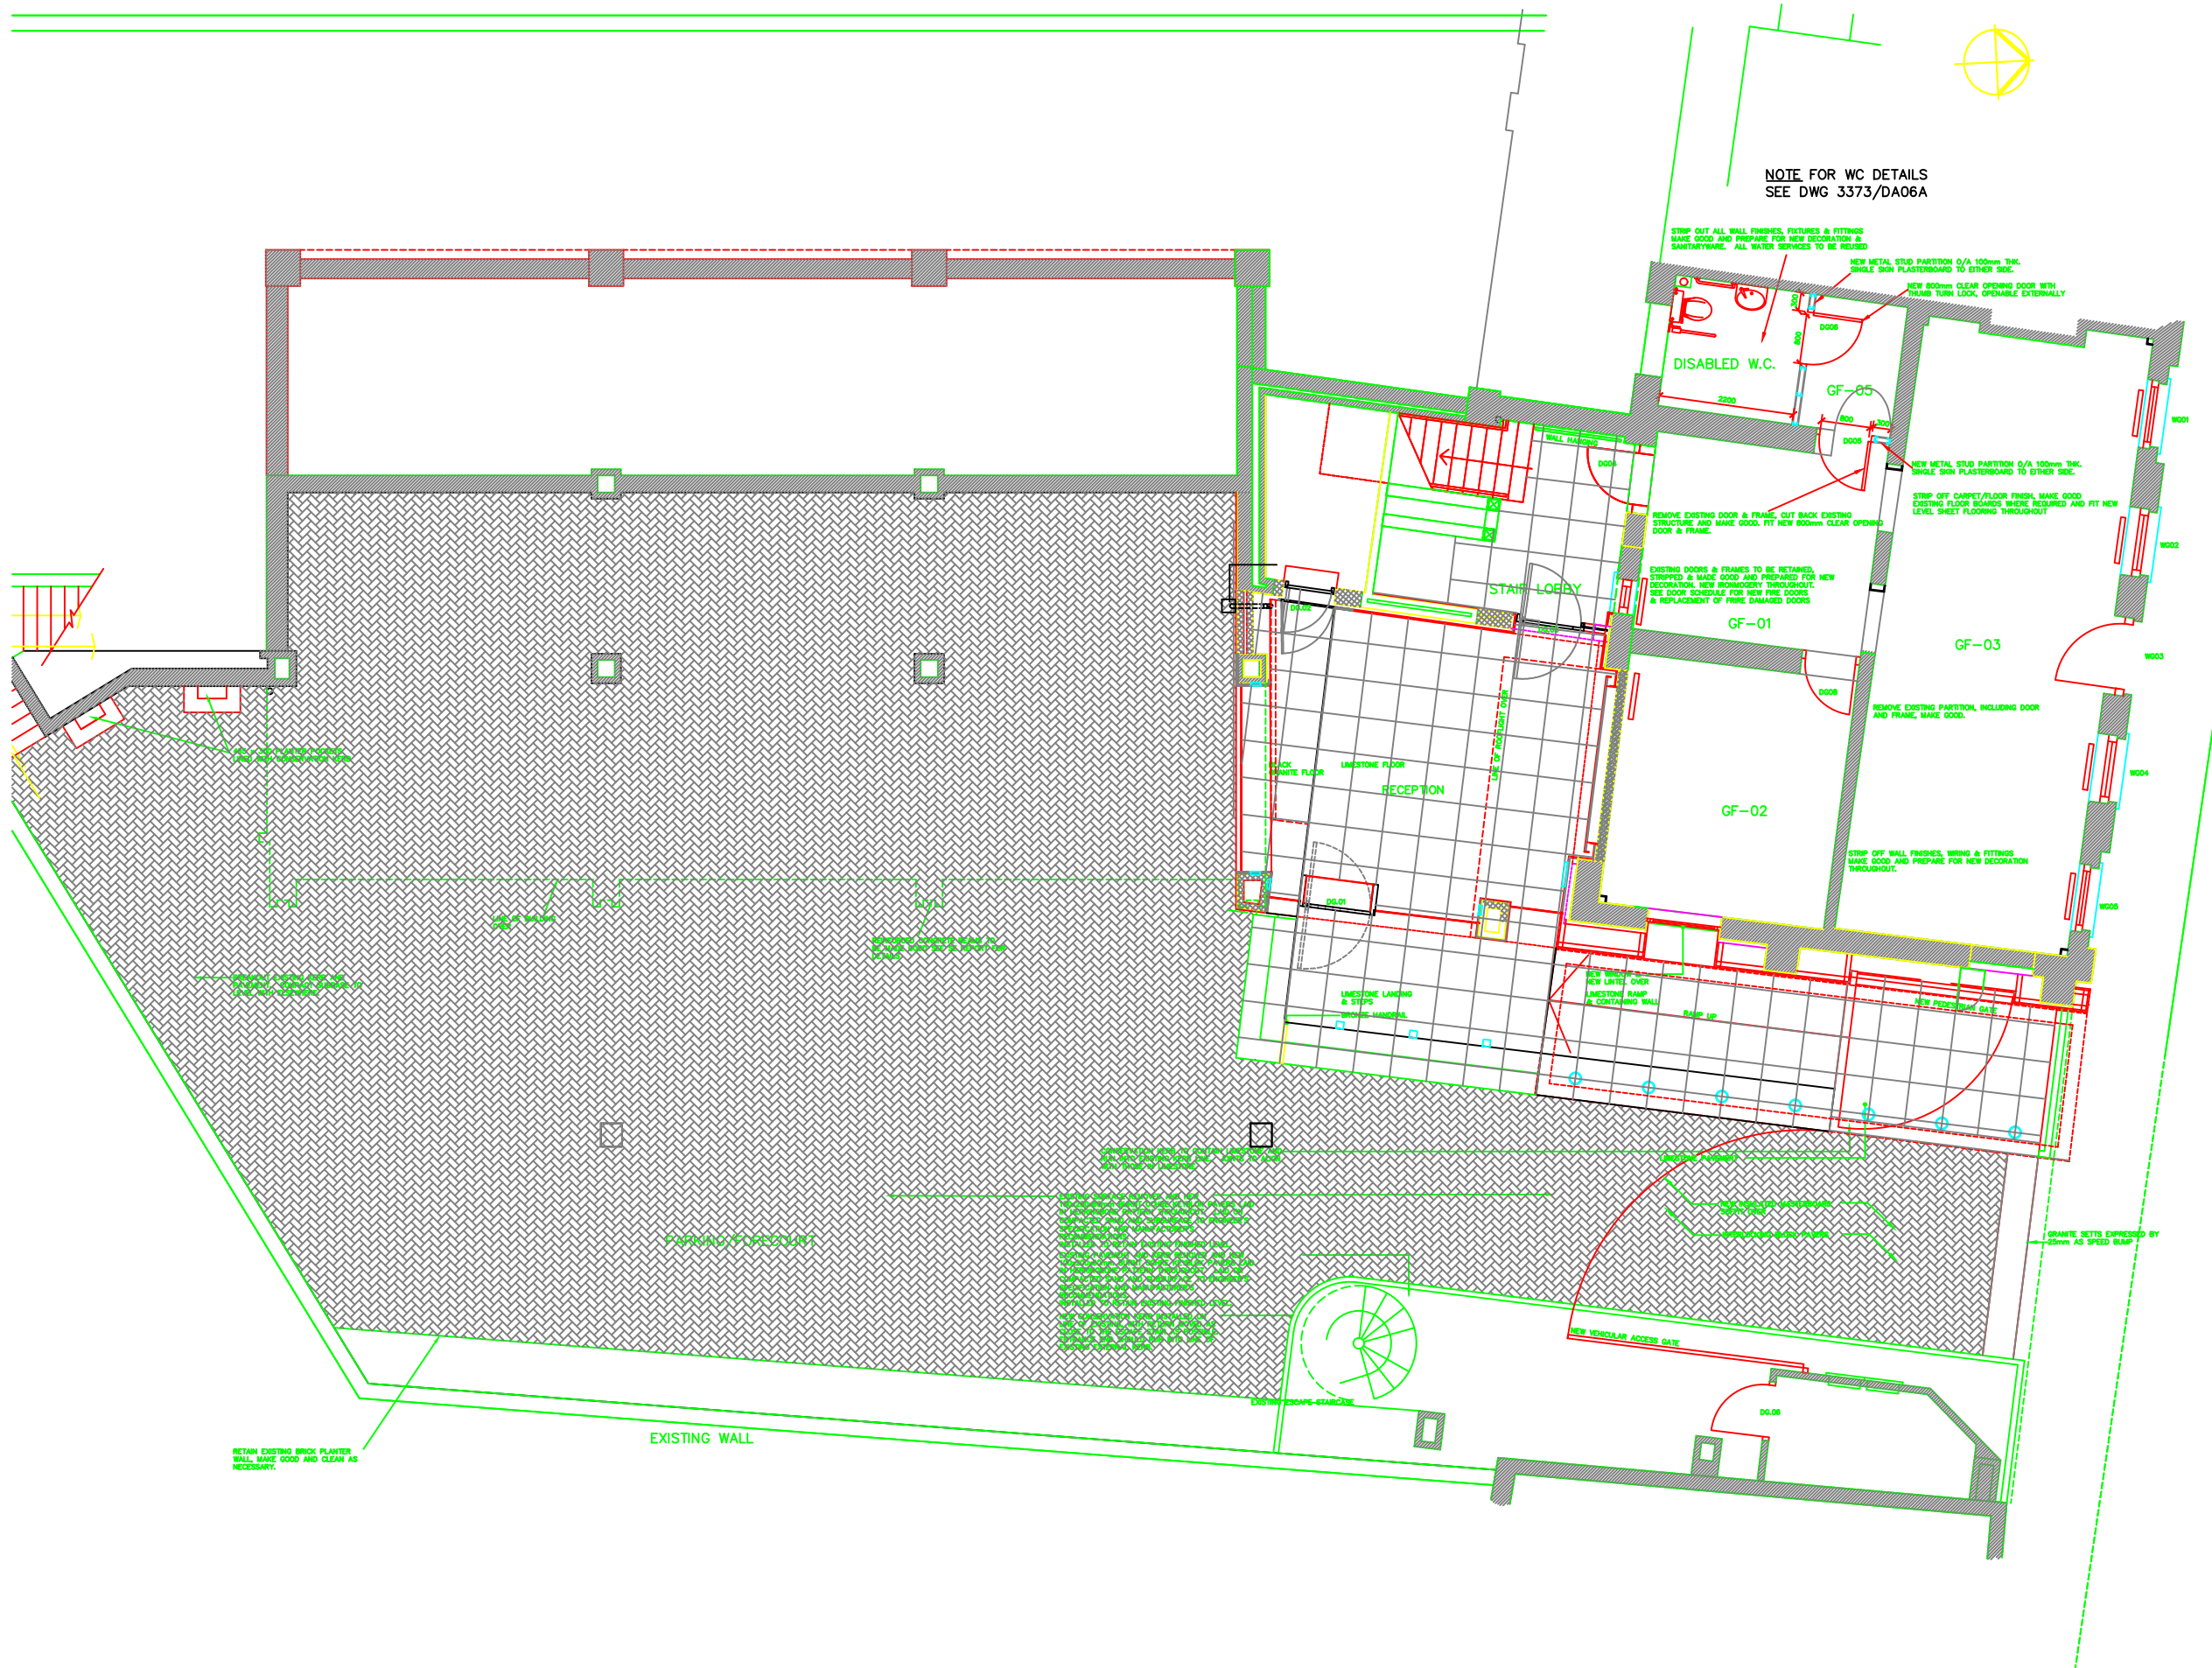

REV C	AS BUILT DRAWING	27/09/01
REV B	DETAILS OF PAVING REVISED	06/08/01
REV A	GENERAL UPDATE	20/02/01

CODE	DESCRIPTION	INITIAL
REVISIONS		

McKAY SECURITIES PLC

CLIENT

REFURBISHMENT OF
ALBION HOUSE
OXFORD ROAD, NEWBURY

PROJECT

GROUND FLOOR PLAN
AS PROPOSED

DRAWING

PROJECT NUMBER 3373 | DRAWING NUMBER GA20 | C

SCALE 1:50 | DATE JAN 01 | DRAWN S.D. | CHECKED

NEWBURY The Long Barn - Welford - Newbury - RG20 9WZ
Telephone (01488) 457927
Fax (01488) 457927
email@begin-architects.demon.co.uk

LONDON 25 Manchester Square - London - W1M 5AP
Telephone (020) 7486 9466
Fax (020) 7486 8467
email@begin-architects.demon.co.uk

BATH 25 Molford Street - Bath BA1 2BT
Telephone (01225) 483277
Fax (01225) 483277
email@begin-architects.demon.co.uk

© O. ARCHITECTURAL PARTNERSHIP'S PLC 1990
Check all dimensions and report any errors or omissions. Do not scale this drawing



SUTTON GRIFFIN
& MORGAN

Chartered Architects
Project Managers - Planners - Interior Designers - Landscape Designers