


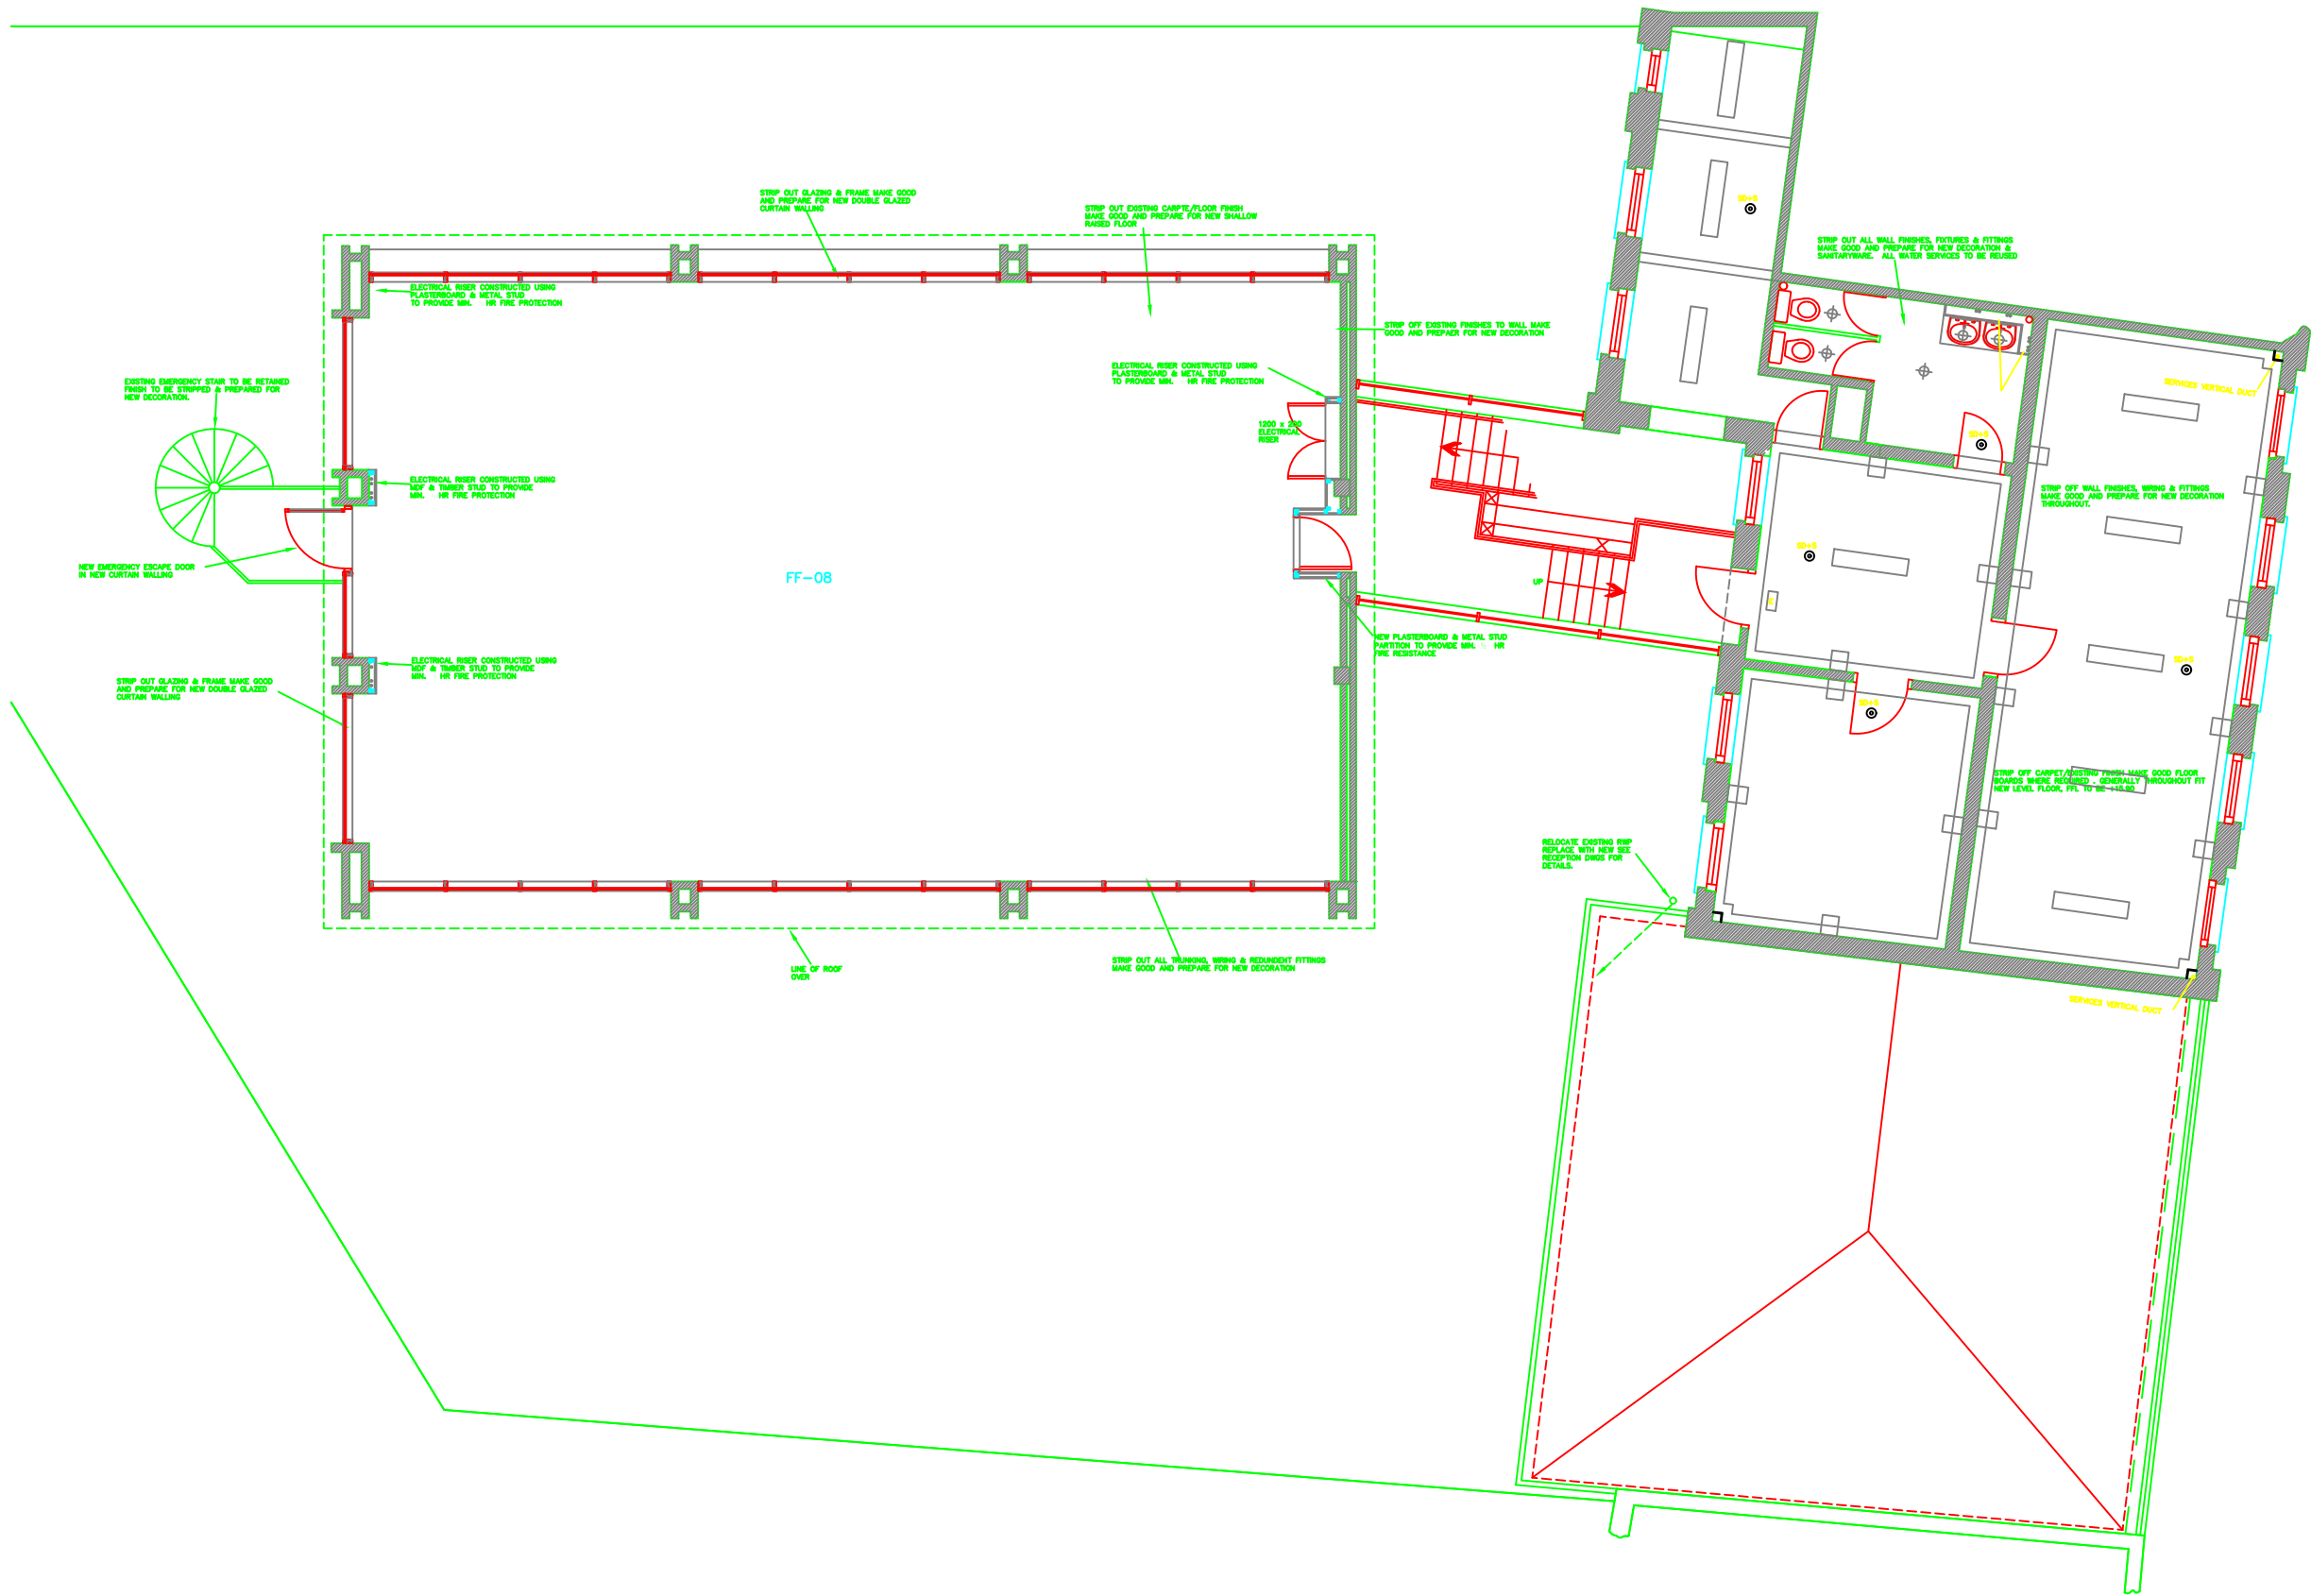

REV B	AS BUILT DRAWING	27/09/01
REV A	GENERAL UPDATE	20/02/01
CODE	DESCRIPTION	INITIAL
REVISIONS		

McKAY SECURITIES PLC

CLIENT

REFURBISHMENT OF
ALBION HOUSE
OXFORD ROAD NEWBURY

PROJECT

SECOND FLOOR PLAN
AS PROPOSED

-

DRAWING	
PROJECT NUMBER	3373
DRAWING NUMBER	GA22 B
SCALE	1:50
DATE	JAN 01
DRAWN S.D.	
CHECKED	

NEWBURY	The Long Barn , Welford , Newbury , RG20 9WZ
	Telephone (01488) 457927
	Fax (01488) 457927
	email@begin-architects.demon.co.uk
LONDON	25 Manchester Square , London , W1M 5AP
	Telephone (020) 7496 9466
	Fax (020) 7496 8487
	email@begin-architects.demon.co.uk
BATH	26 Molford Street , Bath BA1 2BT
	Telephone (01225) 483277
	Fax (01225) 483277
	email@begin-architects.demon.co.uk

© O. ARCHITECTURAL PARTNERSHIP'S PLC 1990
Check all dimensions and report any errors or omissions. Do not scale this drawing