


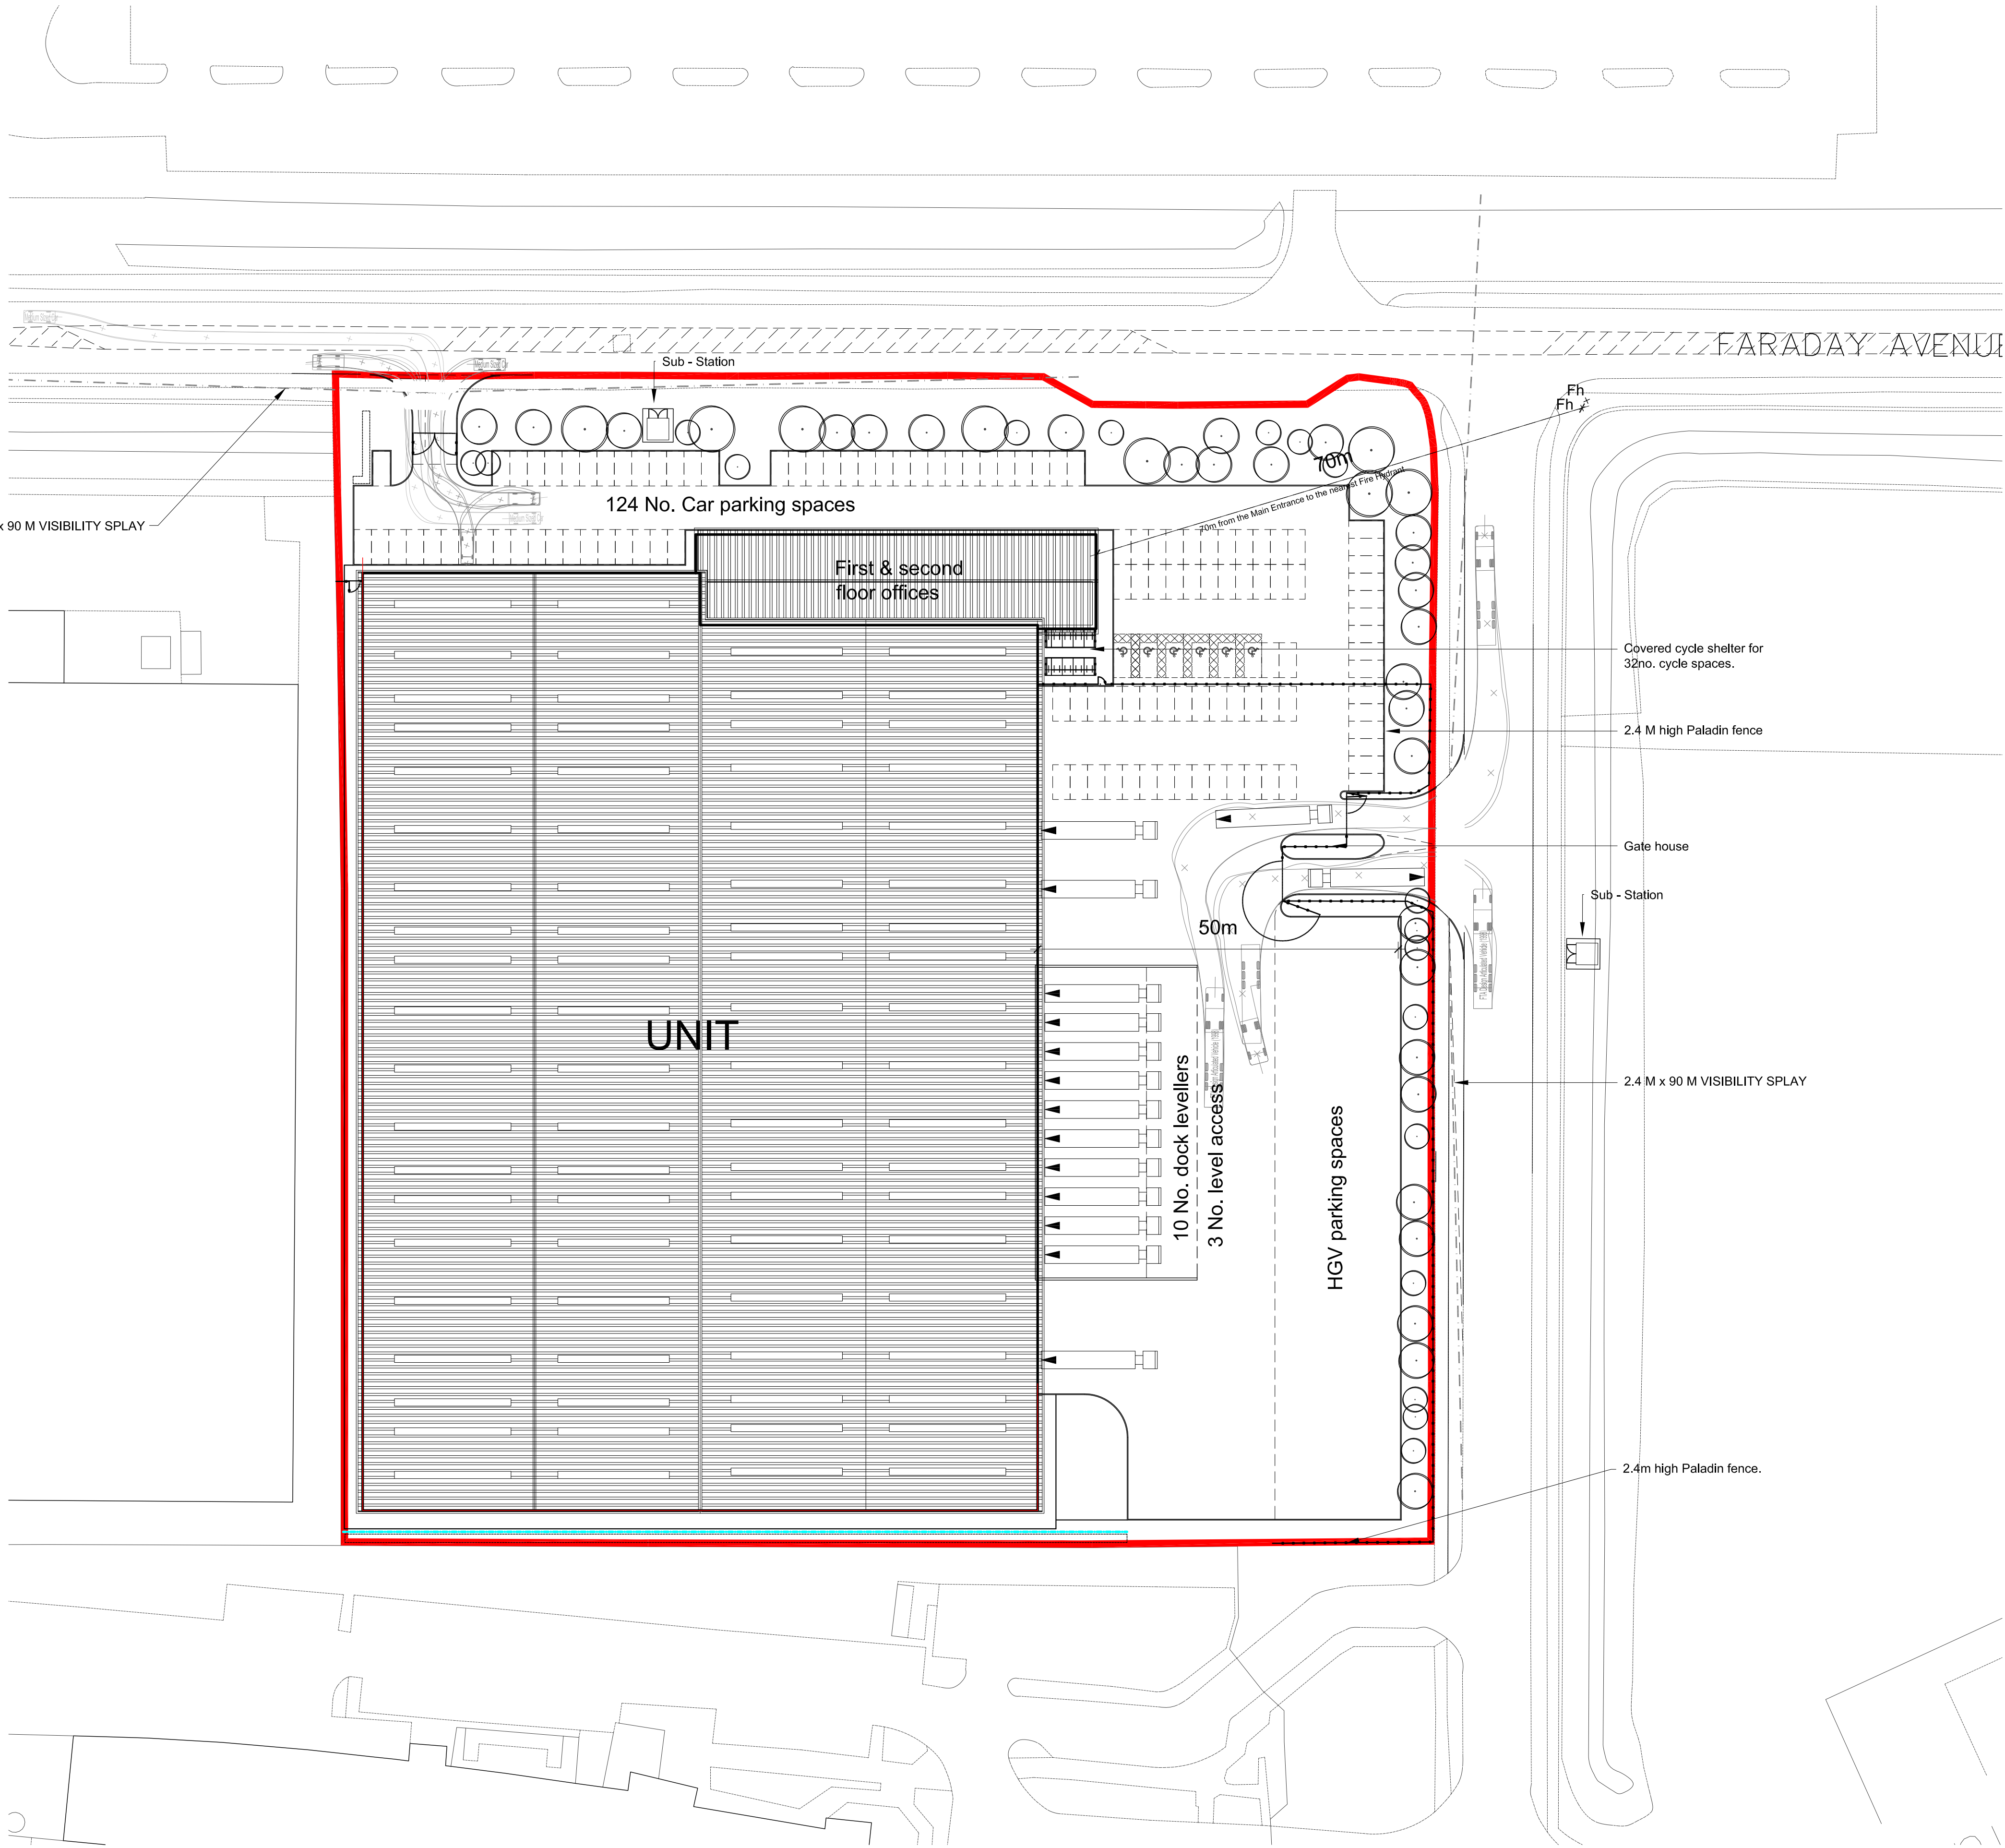

NOTES:

SUBJECT TO STATUTORY CONSENTS

SUBJECT TO SURVEY

BASED ON OS MAP REPRODUCED BY PERMISSION OF CONTROLLER OF HM STATIONARY OFFICE (c) CROWN COPYRIGHT

COPYRIGHT RESERVED

DO NOT USE ELECTRONIC VERSIONS OF THIS DRAWING TO DETERMINE DIMENSIONS UNLESS SPECIFICALLY AUTHORISED BY MICHAEL SPARKS ASSOCIATES

IF USING AN ELECTRONIC VERSION OF THIS DRAWING FIGURED DIMENSIONS TAKE PRECEDENCE AND NOTIFY MICHAEL SPARKS ASSOCIATES OF ANY DISCREPANCIES



AS BUILT					
THIS "AS-BUILT" DRAWING IS BASED ON INFORMATION SUPPLIED TO MICHAEL SPARKS ASSOCIATES BY WINVIC AND INCORPORATES INSTRUCTIONS AND OTHER DESIGN INFORMATION GIVEN TO WINVIC DIRECTLY BY OTHERS					
G	07/04/2015	AS BUILT ISSUE. Refer to subcontractors drawings for specialist details.	LP	AC	
F	29/01/2015	Issue for Construction	AT	AC	
E	17/12/2014	Fence position around service yard updated	AT	AC	
D	29/10/2014	Sub station position updated	AT	AC	
C	28/09/2014	Roof verge adjusted following Main Contractor comments.	AT	AC	
B	16/09/2014	Fire Hydrant added	AT	GZ/AC	
A	24/07/2014	Visibility splay, tracking to car parking added, gate to service yard updated	GZ	AC	
-	28/03/2014	Issue for tender	LP	AC	
REV	DATE	NOTE	DRAW	CHK	



CHARTERED ARCHITECTS

11 PLATO PLACE
SEBURNS ROAD
LONDON SW6 4TU

TELEPHONE 020 7736 6162
FAX 020 7736 3896
www.msa-architects.co.uk

TITLE

PLOTS 6B, HAMS HALL

DRAWING

SITE LAYOUT PLAN

CLIENT

CANMOOR

DATE	SCALE	DRAWN
MARCH 2014	1:500@A1	AT
STATUS	AS BUILT	CHECKED
		AC

DRAWING NUMBER

30354-RE-201G