


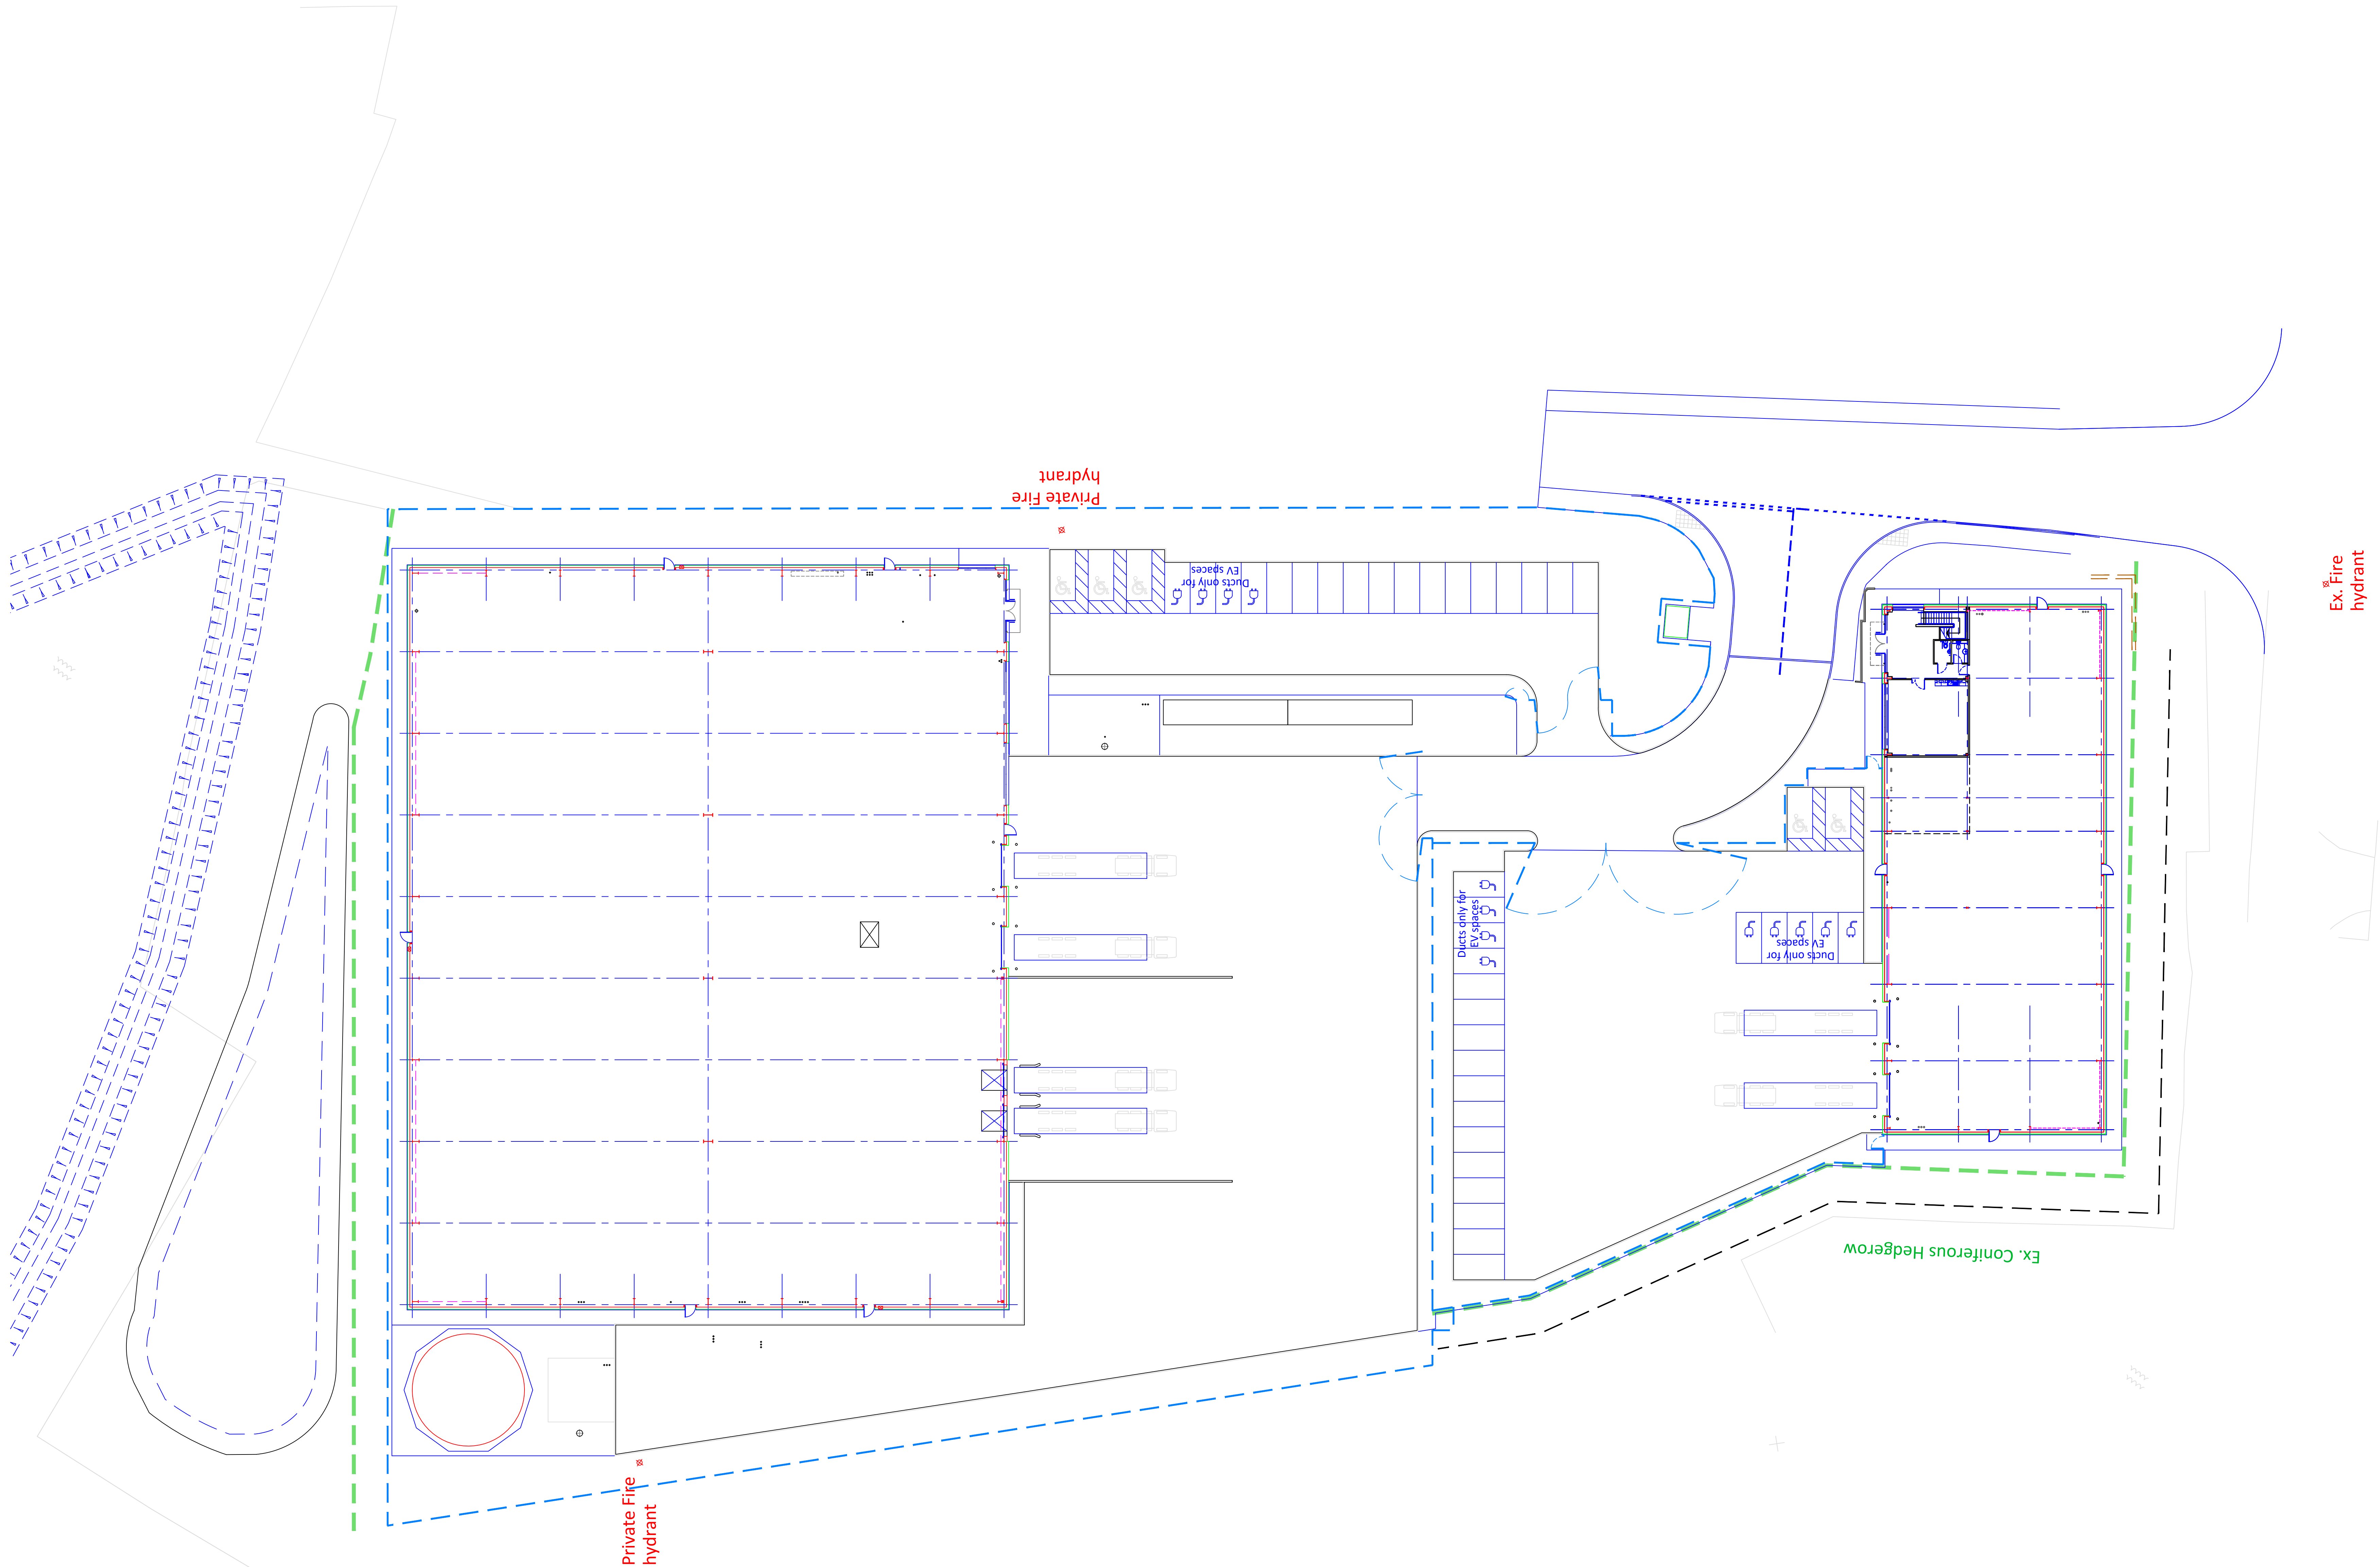

notes
this drawing and design is the copyright of aja architects llp and must not be reproduced in part or in whole without prior written consent. contractors must verify all dimensions on the before commencing work or preparing shop drawings.
Where this drawing contains any Ordnance Survey mapping material, it has been reproduced under license number 100032278.
Ordnance Survey © Crown copyright

C13.22.05.23	issued as Record drawing	up	
C12.04.07.22	pumphouse base ductwork co-ordinates added as 01.07.22 email	up	
C11.01.07.22	pumphouse base and external services added as Barnwood email 01.07.22 and SPM	up	
C10.27.06.22	following Barnwood instruction	up	
C09.10.06.22	gate tank & pumphouse co-ordinates revised to suit engineer's layout	up	
C08.10.05.22	Gate co-ordinates revised to suit s/c details	up	
C07.31.03.22	Fire hydrant position revised	up	
C06.25.03.22	co-ordinates revised to suit updated site plan as	up	
C05.01.03.22	as 08.02.22 email engineer's details	up	
C04.09.02.22	Unit 14 EV spaces identified	up	
C03.02.02.22	Further co-ordinates added	up	
C02.21.01.22	Unit 44 Office omitted as 20.01.22 instruction	up	
C01.08.12.21	Construction Issue Co-ordinates to pumphouse and sprinkler tank added as	up	
P0426.11.21	Building plan and site plant	sm	
P034.10.21	Settling out added	sm	
P0227.09.21	Settling out added	sm	
P0111.08.21	Preliminary Issue	up	
no.	date	revision	by

 **architects**

aja architects llp
1170 Elliott Court
Herald Avenue
Coventry Business Park
COVENTRY CV5 6UB

T: 024 7625 3200
F: 024 7625 3210
E: aja@aja-architects.com
W: www.aja-architects.com

AJA ARCHITECTS is the trading name of AJA ARCHITECTS Consulting Limited (a limited company no. 10667791) and AJA ARCHITECTS LLP (limited liability partnership registered in England no. OC30711).

client

P:\LOGOS\Barberry-text-logo-blue 2019.png

project

Severn Road
Bristol

drawing

Unit 44
Site Setting Out

scale 1:200 @ A0 drawn up

checked mjl date 11.08.21

no

6701 — 202 Rev C
RECORD