
STATUTORY STATUS	
LISTED	YES - GRADE II
CONSERVATION	YES

- TITLE BLOCK ADDRESS POST CODE UPDATED.
- SECURE ZONE LINE ADDED.
- ALL AREA ZONES UPDATED.
- ALL CEILING HEIGHT BLOCKED UPDATED.
- PLANNING STATUTORY STATUS
- AREA SCHEDULE UPDATED.

Area Schedule (m²) and (ft²)

	Old Customer		New Customer		Existing Back Office		New Back Office		Other Bank Area		Customer Gain		Internal Area		Gross Area	
	(m²)	(ft²)	(m²)	(ft²)	(m²)	(ft²)	(m²)	(ft²)	(m²)	(ft²)	(m²)	(ft²)	(m²)	(ft²)	(m²)	(ft²)
Ground	142.61	1535	142.61	1535	155.63	1675	155.63	1675	8.14	88	0	0	320.17	3446	365.83	3938
First	100.12	1078	100.12	1078	74.90	806	74.90	806	54.94	591	0	0	248.51	2675	311.04	3348
Second	0.00	0	0.00	0	50.02	538	50.02	538	7.30	79	0	0	60.25	649	92.91	1000
Total Area	243	2613	243	2613	281	3020	281	3020	70	758	0	0	629	6770	770	8286

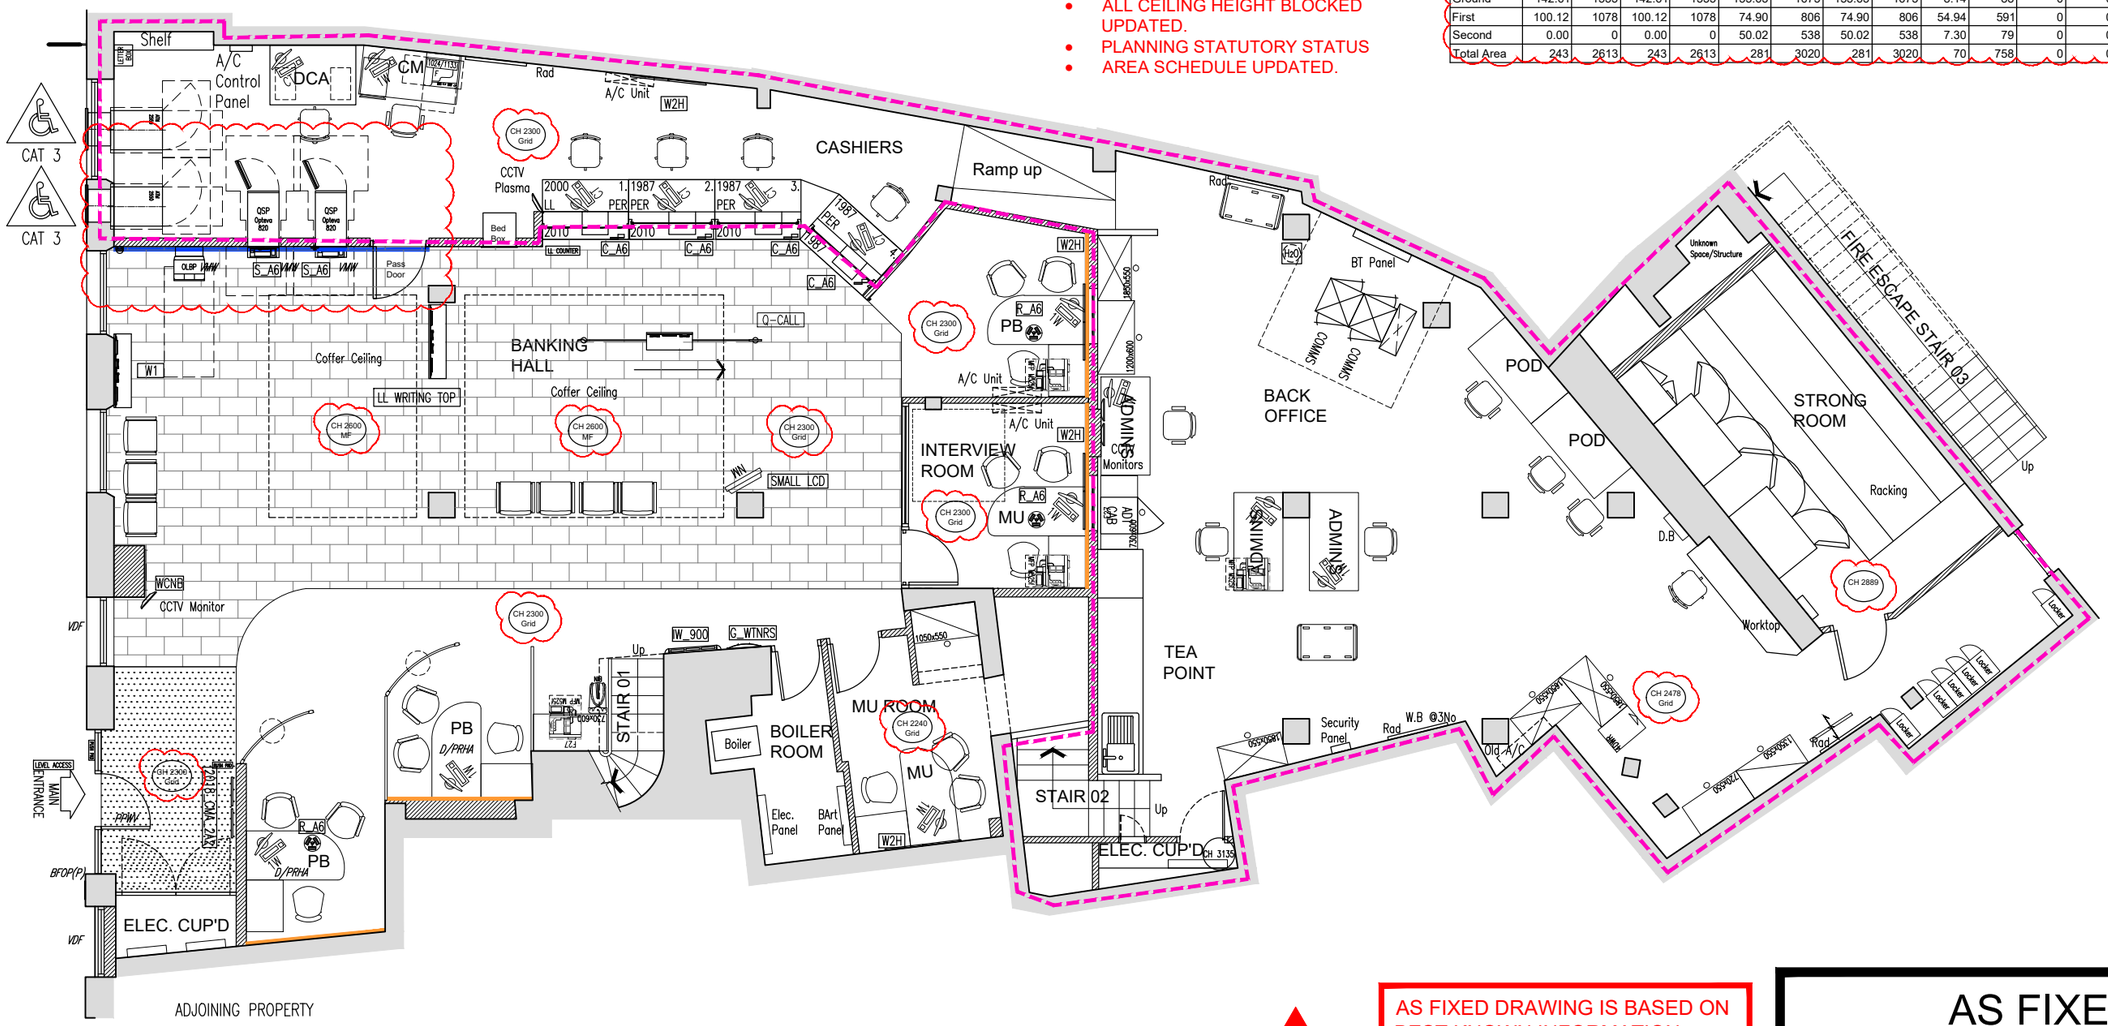

SCALE
0 1m 5m 10m

AS FIXED DRAWING IS BASED ON BEST KNOWN INFORMATION DOWNLOADED FROM EDMS (REF:A0428_002) AND POST COMPLETION CONTRACTOR MARKUP (BUBBLED AREA).

AS FIXED

CONFIDENTIAL

NOTE
This drawing has been prepared from historical information that cannot be guaranteed accurate. Responsibility is not accepted for errors made by others in scaling from this drawing. All construction information should be taken from figured dimensions only. All dimensions should be checked on site prior to the manufacture of any components. No services should pass through or over the Boxes & Parcels room. No sprinklers to be located in the Comms room.

HATCHING

- New Secure Partition wall
- New Partition wall
- Book Room Secure wall
- Existing Partition wall
- Structural wall
- Area not in scope
- Barrier Matting
- Banking Hall Vinyl Flooring
- Staff Room Vinyl Flooring

DATE :	REV	DRAWN	CHECKED	NOTES.

ISG
Boleyn House,
St Augustines
Business Park,
Whitstable
Kent CT5 2QJ

Project
BICESTER
36 MARKET SQUARE,
BICESTER
OX6 7AQ
PIM NO. 12556

BARCLAYS

Drawing Title
GROUND FLOOR LAYOUT
AS FIXED
MINOR WORKS ONE OFF 2022

Branch Sort Code	Branch ID	Supplier Project No
20-06-75	00	BY1081780-072

Scale	Drawn	Checked	Date
1:100@A3	PC	–	09/02/2023

Drg.No	Revision
BY1081780-072_002	-

Architectural Practice: ISG Design Hub