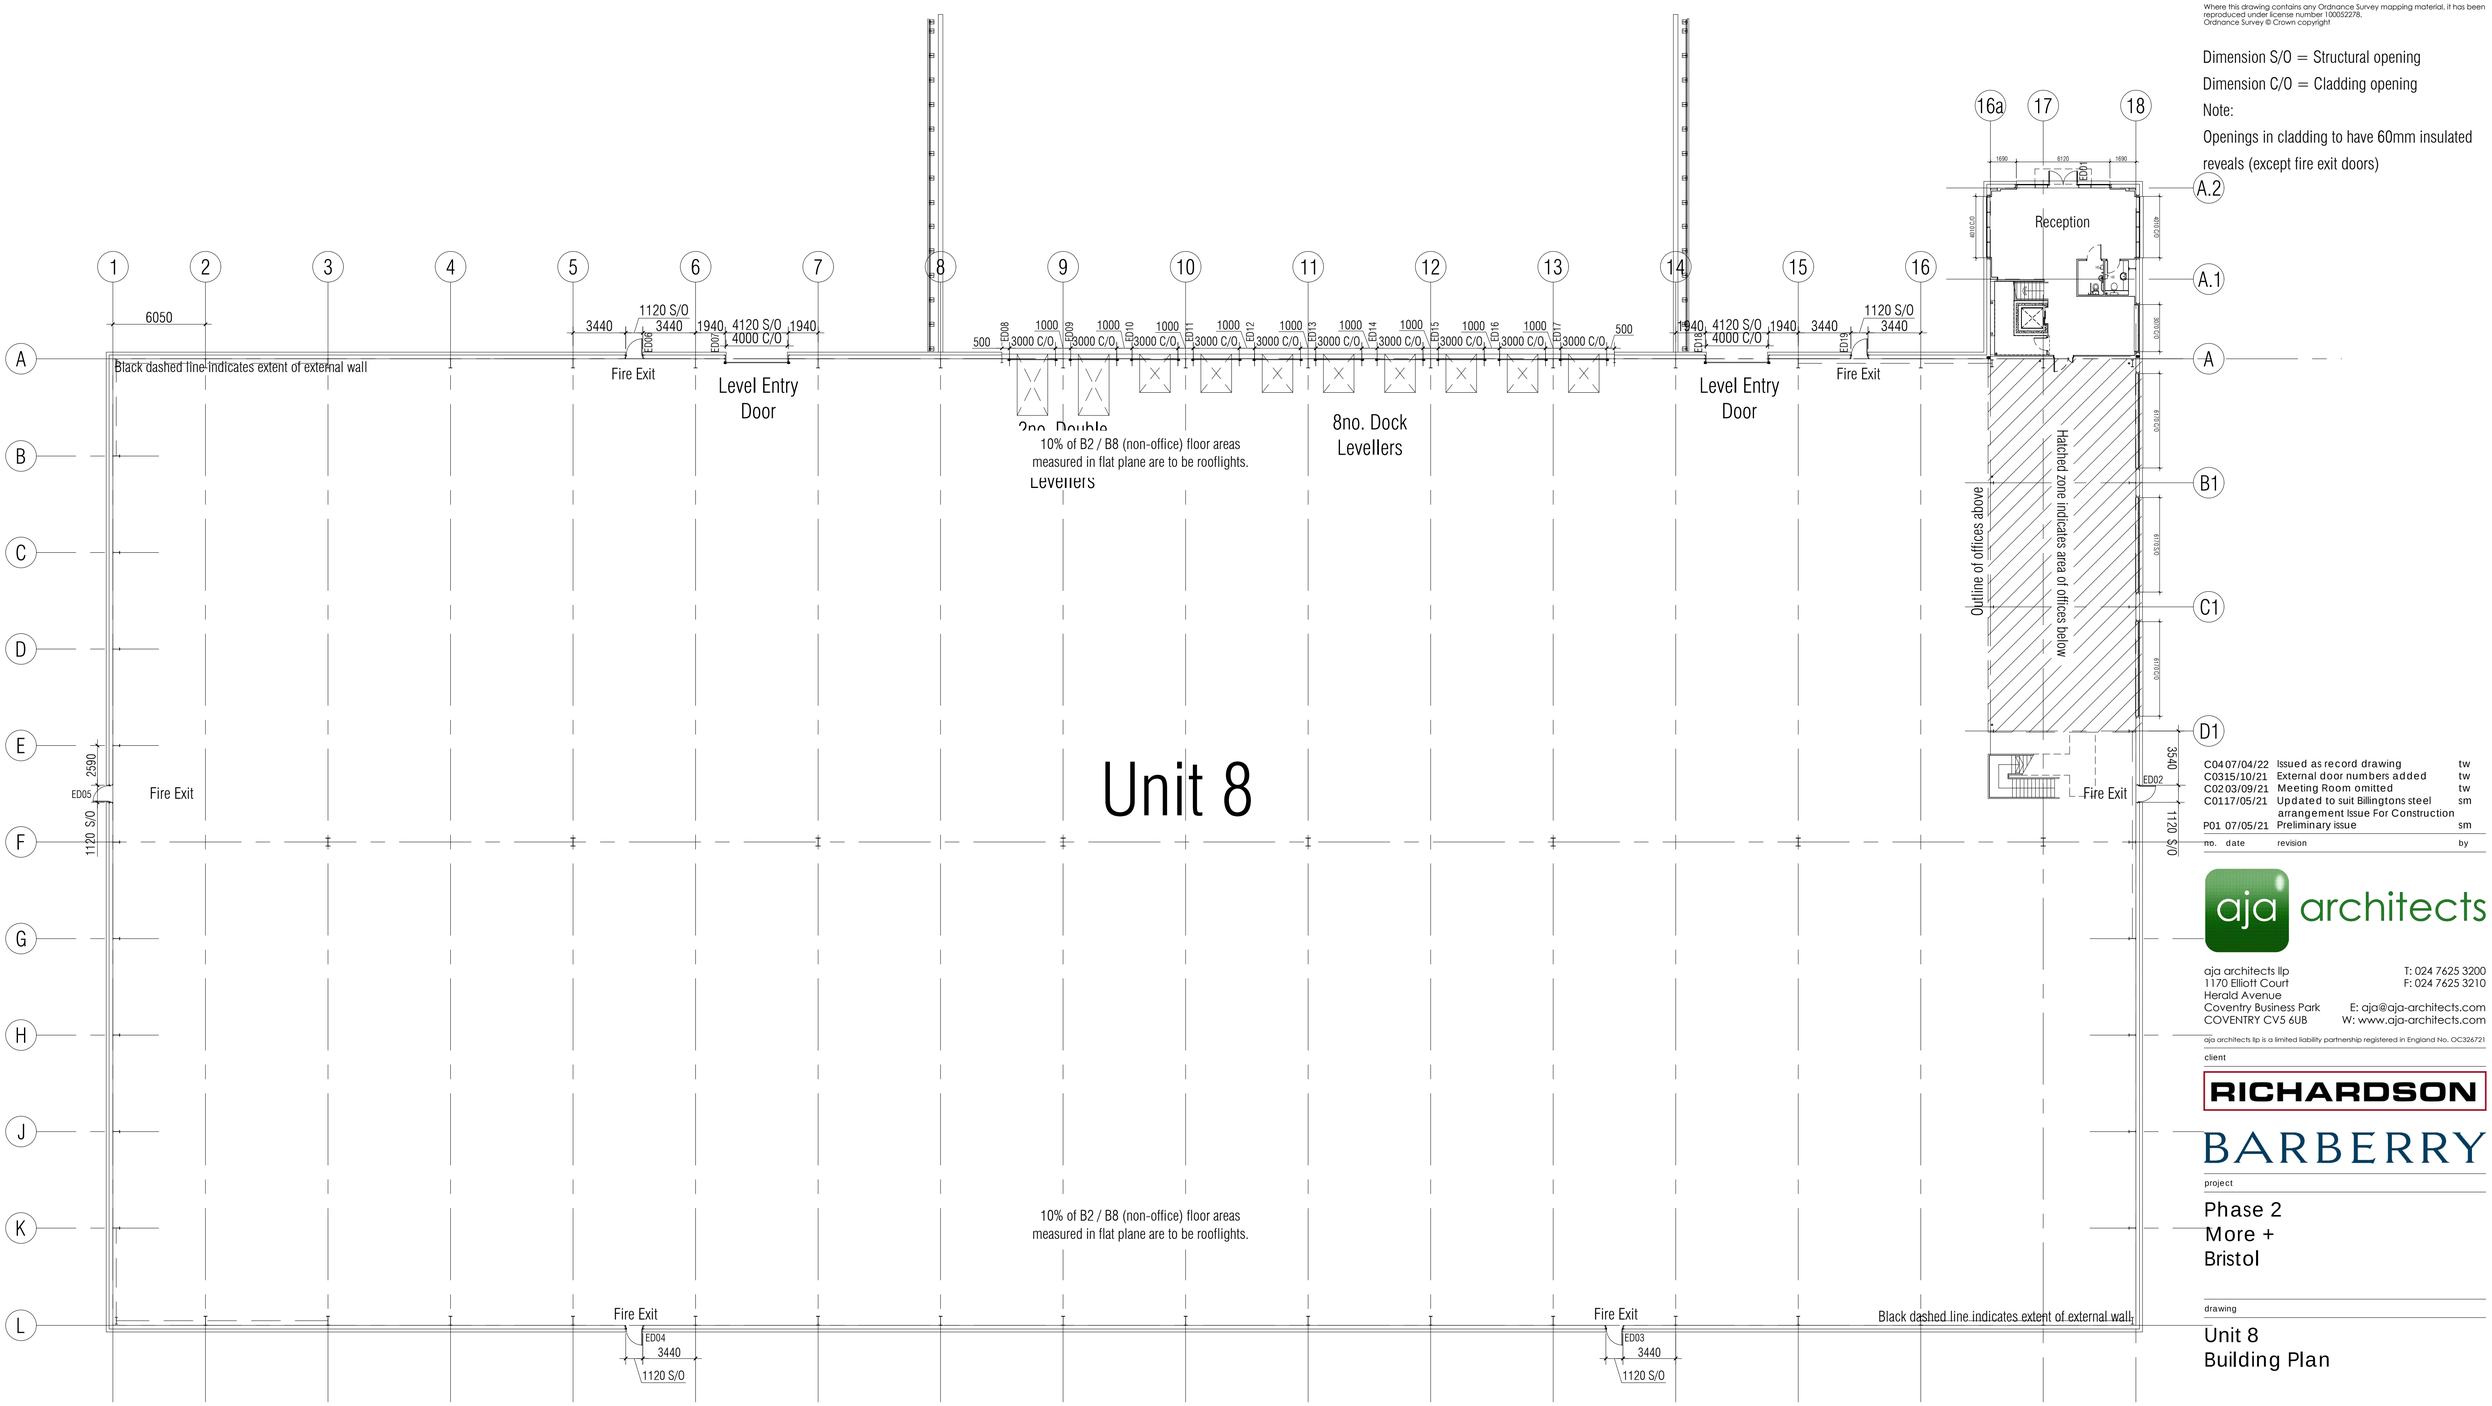


notes

this drawing and design is the copyright of aja architects llp and must not be reproduced in part or in whole without prior written consent. contractors must verify all dimensions on site before commencing work or preparing shop drawings. If in doubt ASK.

Where this drawing contains any Ordnance Survey mapping material, it has been reproduced under license number 100052278.
Ordnance Survey © Crown copyright

Dimension S/O = Structural opening

Dimension C/O = Cladding opening

Note:

Openings in cladding to have 60mm insulated reveals (except fire exit doors)

no.	date	revision	by
C04	07/04/22	Issued as record drawing	tw
C03	15/10/21	External door numbers added	tw
C02	03/09/21	Meeting Room omitted	tw
C01	17/05/21	Updated to suit Billingtons steel arrangement Issue For Construction	sm
P01	07/05/21	Preliminary issue	sm

aja architects

aja architects llp
1170 Elliott Court
Herald Avenue
Coventry Business Park
COVENTRY CV5 6UB

T: 024 7625 3200
F: 024 7625 3210
E: aja@aja-architects.com
W: www.aja-architects.com

aja architects llp is a limited liability partnership registered in England No. OC326721

client

RICHARDSON

BARBERRY

project

Phase 2
More +
Bristol

drawing

Unit 8
Building Plan

scale 1:200 @ a1 drawn sm

checked mjl date 26/4/21

no

6926 - 810 C04

RECORD DRAWING