
IMPORTANT NOTES

Do not scale from the drawings;

- Figured dimensions to be used and not scaled dimensions;
- All sizes, dimensions and setting out to be checked on site by Contractor prior to any order or manufacturing . Any discrepancies to be reported to the Designer/Architect.
- All product information for design intent and Tender purposes only.
- Production drawings must be submitted to Designer/Architect for review and return prior to commencement or manufacture.

IF IN DOUBT REQUEST CLARIFICATION FROM THIS OFFICE.

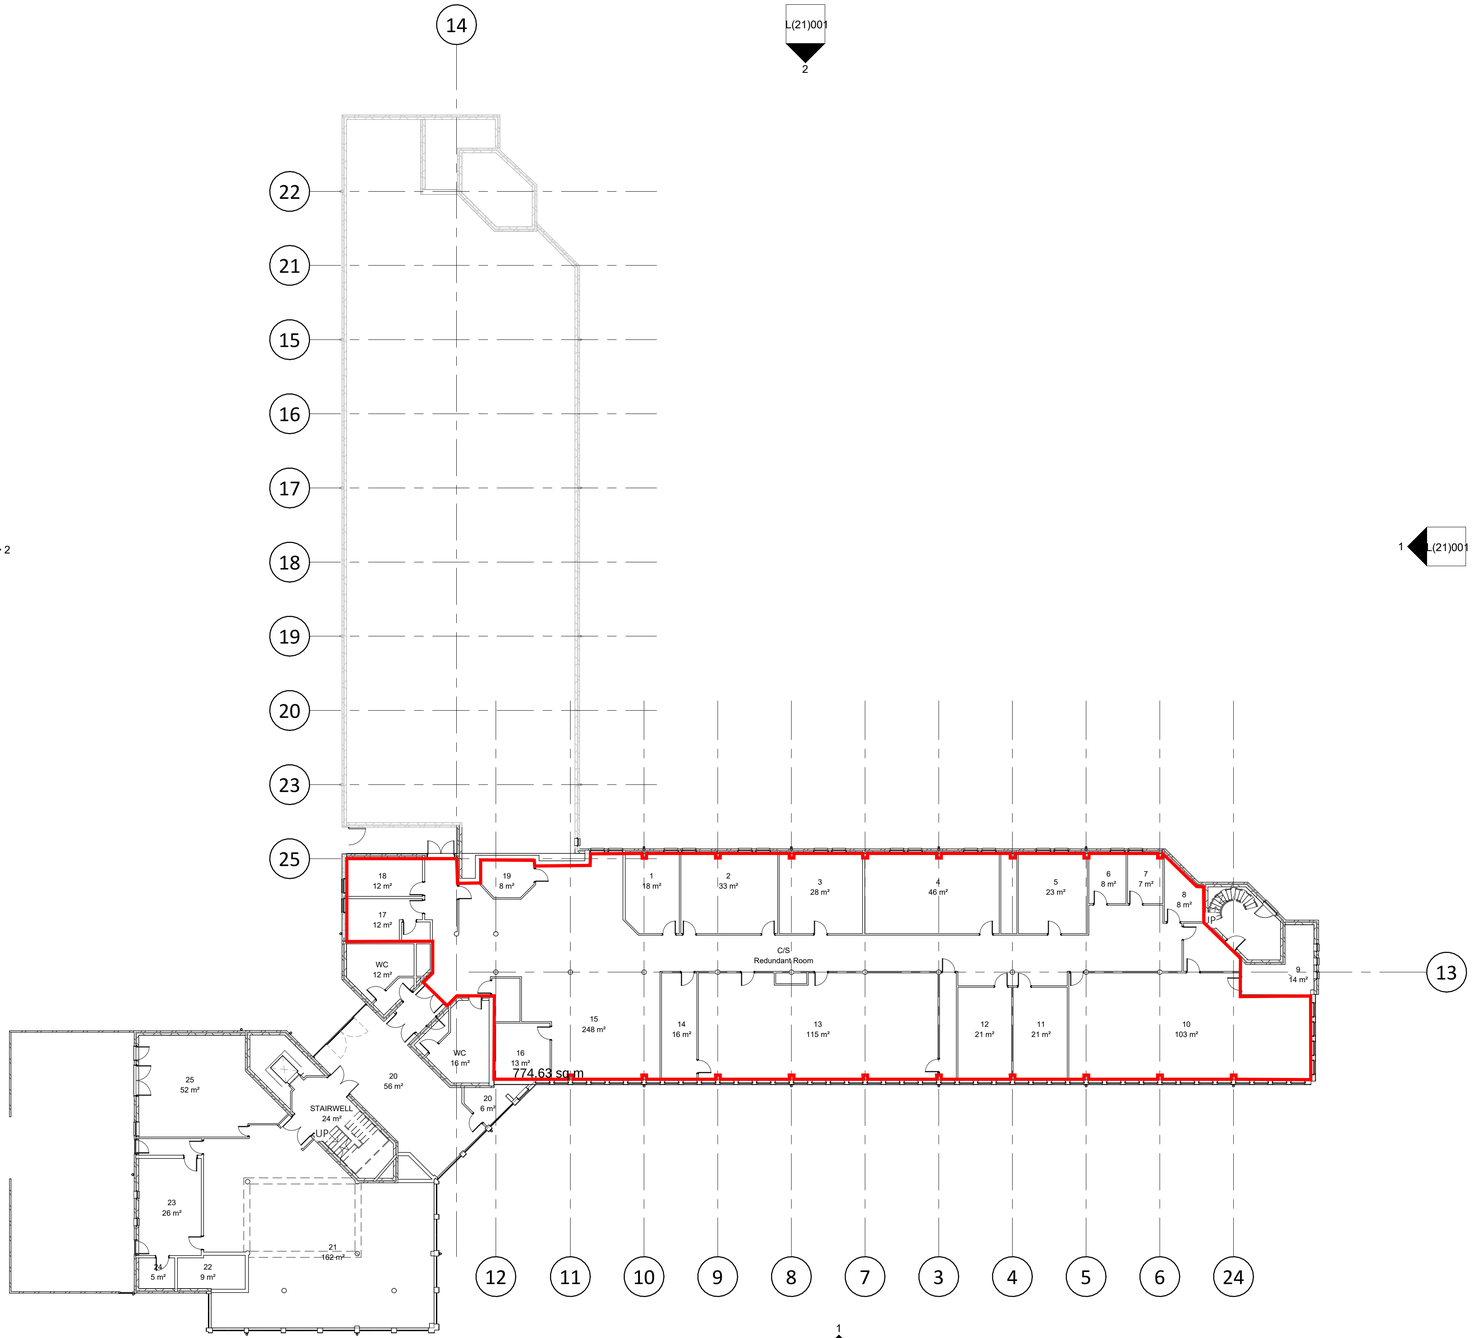

1 **Ground Floor as Existing**
1 : 200

Rev:	Date:	Description:	By:

GRAHAM SIBBALD
Chartered Surveyors and Property Consultants

233 St Vincent Street, Glasgow G2 5QY
Telephone 0141 332 1194 Fax 0141 332 5914
Website: www.g-s.co.uk Email: cad@g-s.co.uk

Client
Padmanor Investments Limited

Project
Southern House As Built

Address
Southern House, Winchester
SO21 2RU

Drawing Title
Ground Floor as Existing

Department No:	Drg No.	Revision	Sheet Size
GB_13530	L(20)001		1 : 200 @A1
Aims No.			Drawing Status
2023 \04 \0103			AS BUILT
Drawn By	Checked By		Date
AMH	CL		07/06/2023

PREPARED BY GRAHAM + SIBBALD TECHNICAL SERVICES LLP